



1" = 1320'

RECEIVED BY OWRD

FEB 12 2013

SALEM, OR

DESCHUTES COUNTY, OREGON


T 17 S, R 11 E, W.M.

SECTION 13 SWNW  
NWSW  
SWSW

SECTION 14 NENE  
SENE  
NESE  
SESE

APPLICATION G-14288

PERMIT G-13153

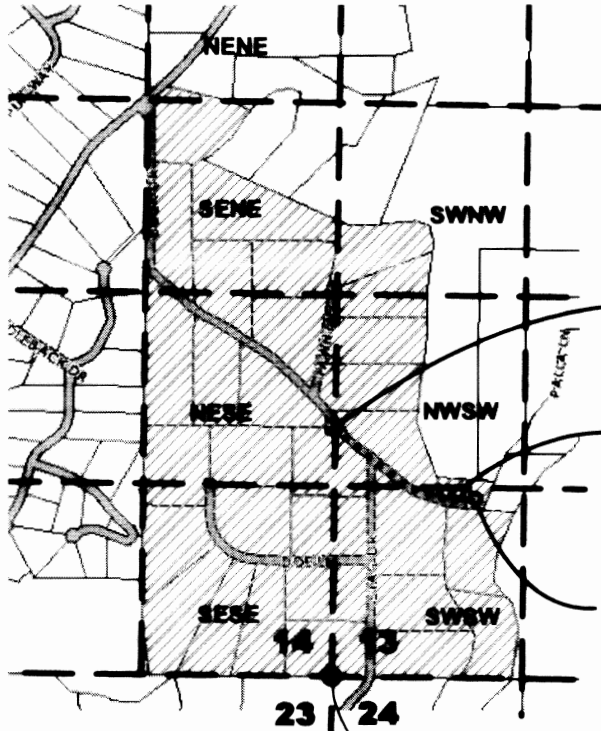


CISTERN AND PUMP

WELL #3 & METER  
1260' NORTH,  
880' EAST FROM  
SW CORNER,  
SECTION 13

WELL #2 & METER  
1220' NORTH,  
990' EAST FROM  
SW CORNER,  
SECTION 13

SW CORNER OF SECTION 13

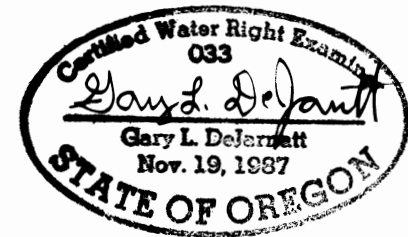

RENEWAL DATE: 12-31-2013



POU - QUASI-MUNICIPAL



QUARTER QUARTER  
BOUNDARIES



PIPELINE

NOTE: THIS MAP IS NOT INTENDED TO  
PROVIDE LEGAL DIMENSIONS OR LOCATIONS  
OF PROPERTY OWNERSHIP LINES.

TITLE

CLAIM OF BENEFICIAL USE MAP for  
KLIPPEL WATER, INC.

WATER RIGHT SERVICES, LLC  
P.O. BOX 1830, BEND OR 97709

WWW.OREGONWATER.US  
(541) 389-2837

DATE

FEB 1, 2013

JOHNSHORT@USA.COM

JOB #

13003