


T.9&10.S. R.4W. W.M.

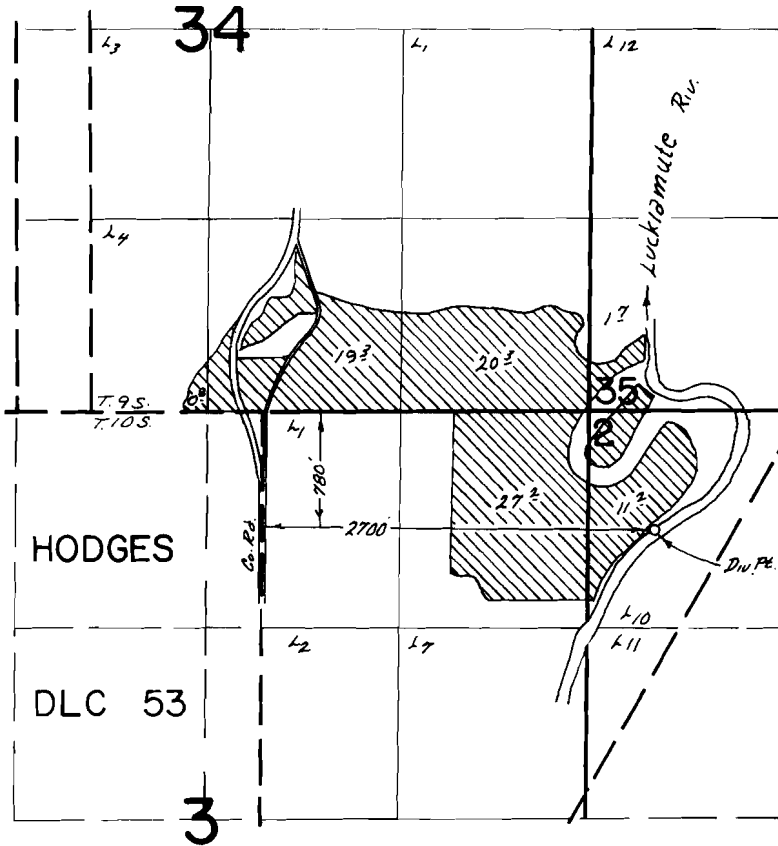

FINAL PROOF SURVEY
UNDER

Application No. 45171 Permit No. 33749
IN NAME OF

DAVID W. & GLADYS M. HAGERBAUMER

Surveyed March 26, 1973, by R. B. Mucken