


T.8S. R.4W., W.M

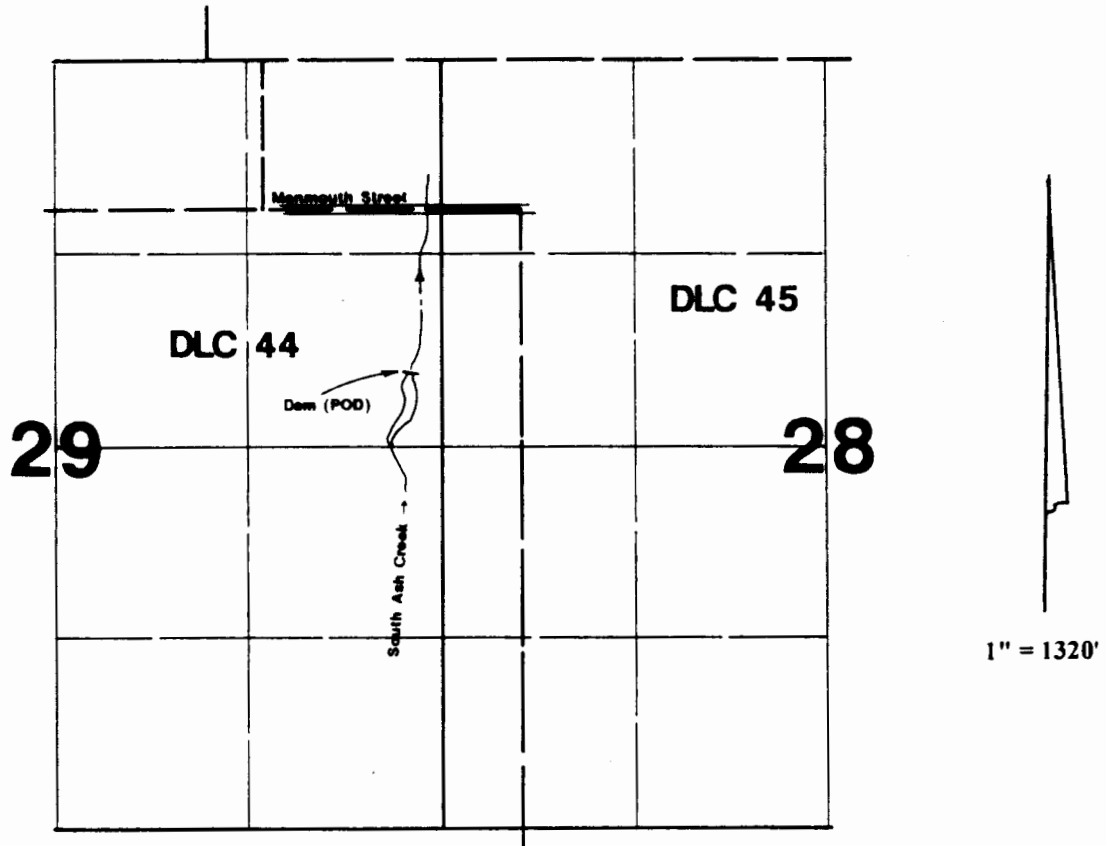

Point of Diversion is located in the SE1/4-NE1/4 of Section 29.

RECEIVED

JUN 08 1999

WATER RESOURCES DEPT
SALEM OREGON

Final Proof Survey

Transfer #: T-7926

In Name Of

City of Independence

Surveyed on May 10, 1999 by JM Schuette

This Map Was Prepared For The Purpose Of Identifying The Location Of A Water Right Only And Is Not Intended To Provide Legal Dimensions Or Location Of Property Ownership Lines.

