



T365 R6W

SEC. 17 SEC. 16

SEC. 16 SEC. 15

SEC. 15 SEC. 14

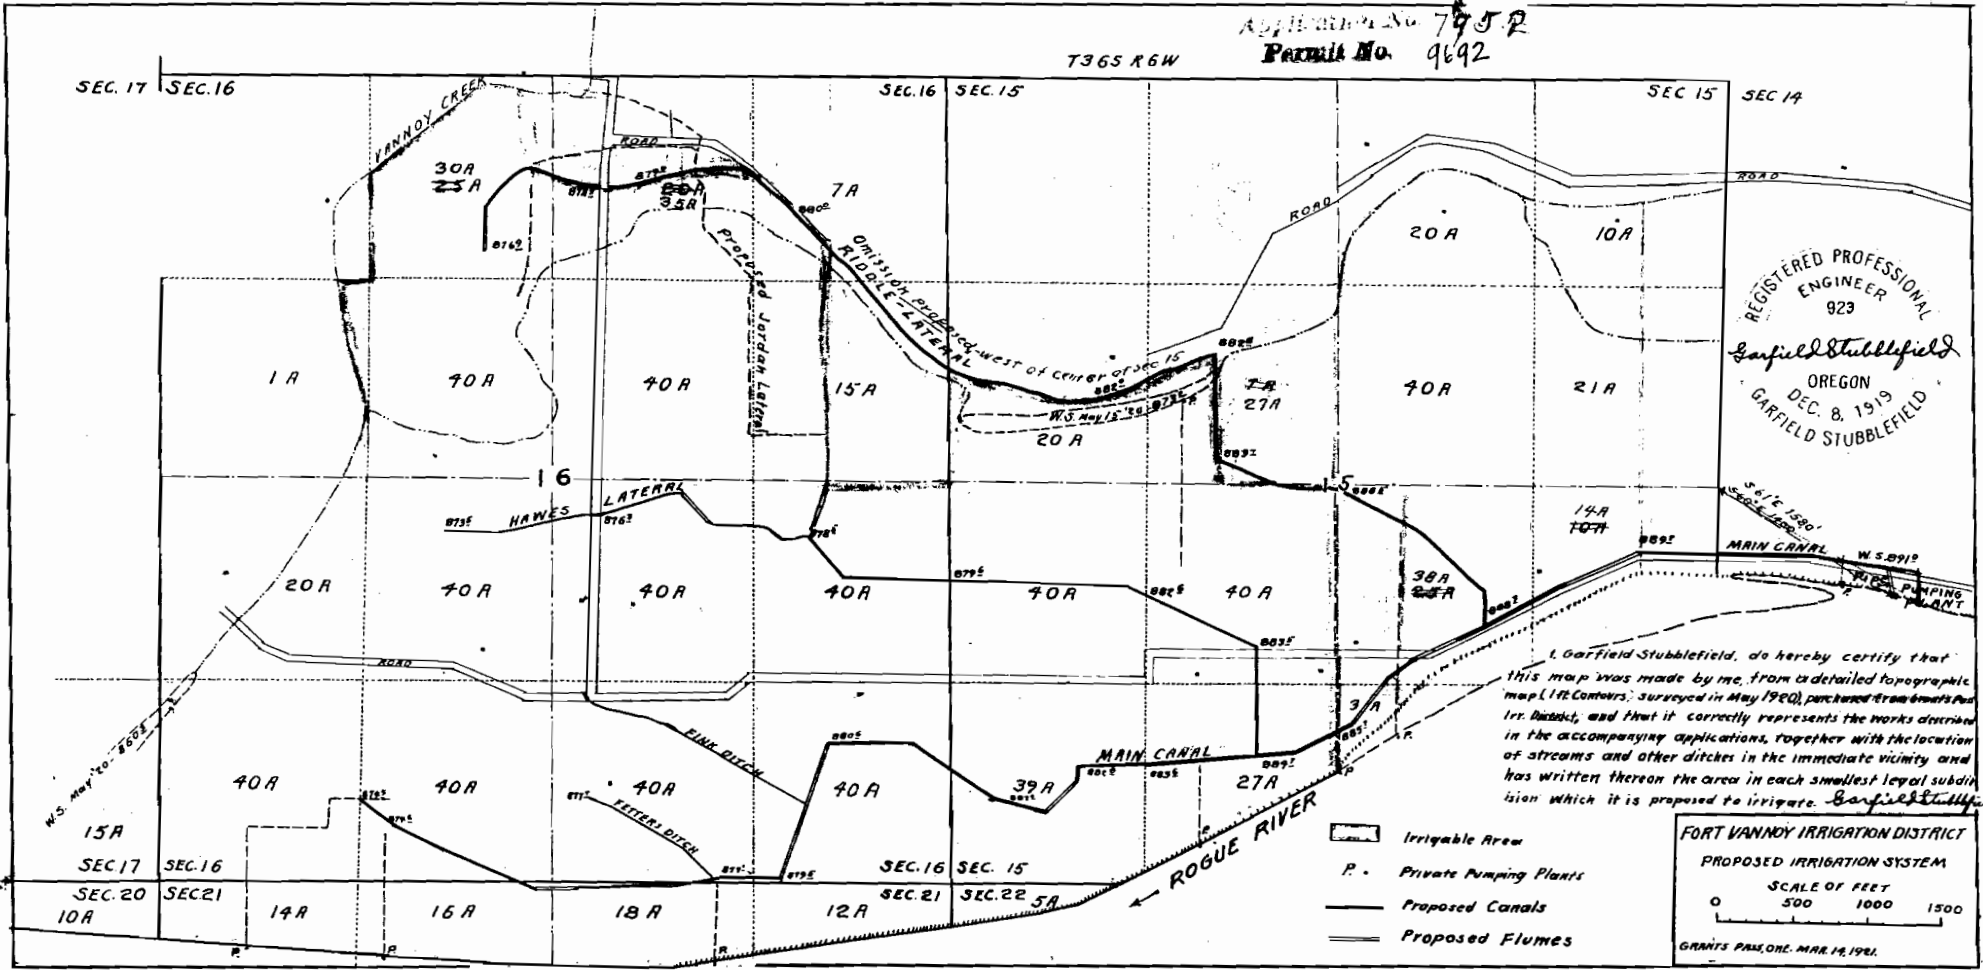

REGISTERED PROFESSIONAL
 ENGINEER
 923
Garfield Stubblefield
 OREGON
 DEC. 8, 1919
 GARFIELD STUBBLEFIELD


I, Garfield Stubblefield, do hereby certify that this map was made by me, from a detailed topographic map, L. H. Comers, surveyed in May 1920, purchased from Grants Post Irr. District, and that it correctly represents the works described in the accompanying applications, together with the location of streams and other ditches in the immediate vicinity and has written thereon the area in each smallest legal subdivision which it is proposed to irrigate. *Garfield Stubblefield*

- Irrigable Area
- Private Pumping Plants
- Proposed Canals
- Proposed Flumes

 PROPOSED IRRIGATION SYSTEM
 SCALE OF FEET
 0 500 1000 1500

T. 36 S. R. 6 W. W.

Permit: S 9692
Volume: 1
Strm: ROGUE R
Trib: PACIFIC OCEAN
Priority: 6/21/30

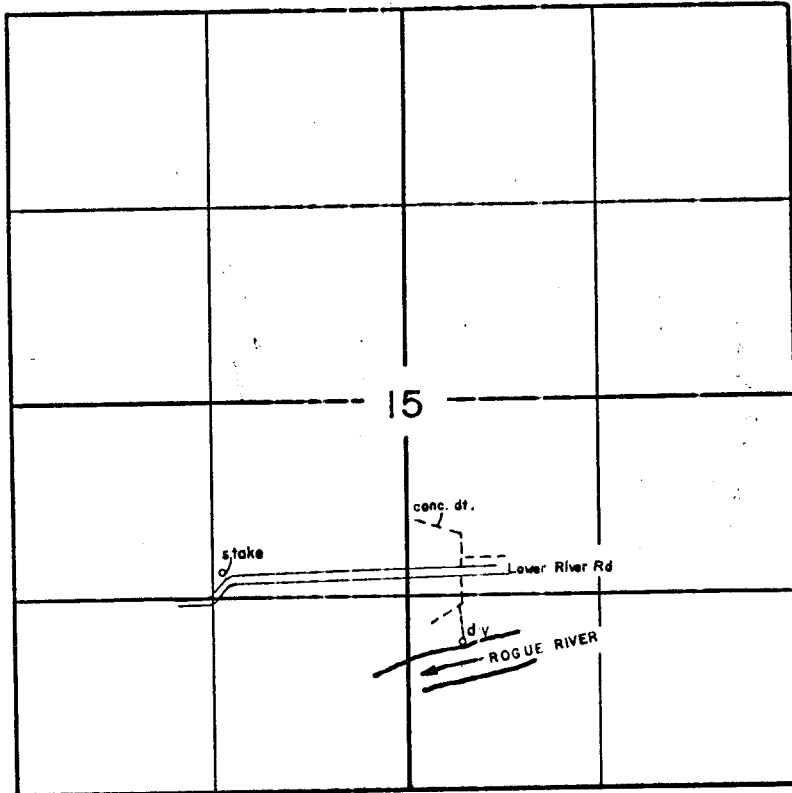

FINAL PROOF SURVEY
UNDER

Application No. _____ Trans. ~~Permit~~ No. F-46
IN NAME OF

FORT VANNOY IRRIGATION DISTRICT

Surveyed June 10, 1965, by R. B. Steimar.