
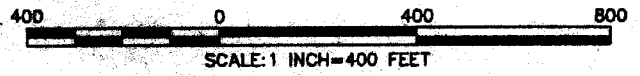


NOTE:
ALL FLOW METERS ARE
LOCATED AT WELL HEADS

CLAIM OF BENEFICIAL USE MAP
IN THE NAME OF:
TREASURE VALLEY COMMUNITY COLLEGE
T 18 S R 47 E SECTION 9 WM
LOCATION OF WELLS
TRANSFER NO. T-9383
CERTIFICATE NO. 22842
PERMIT NO. U-226

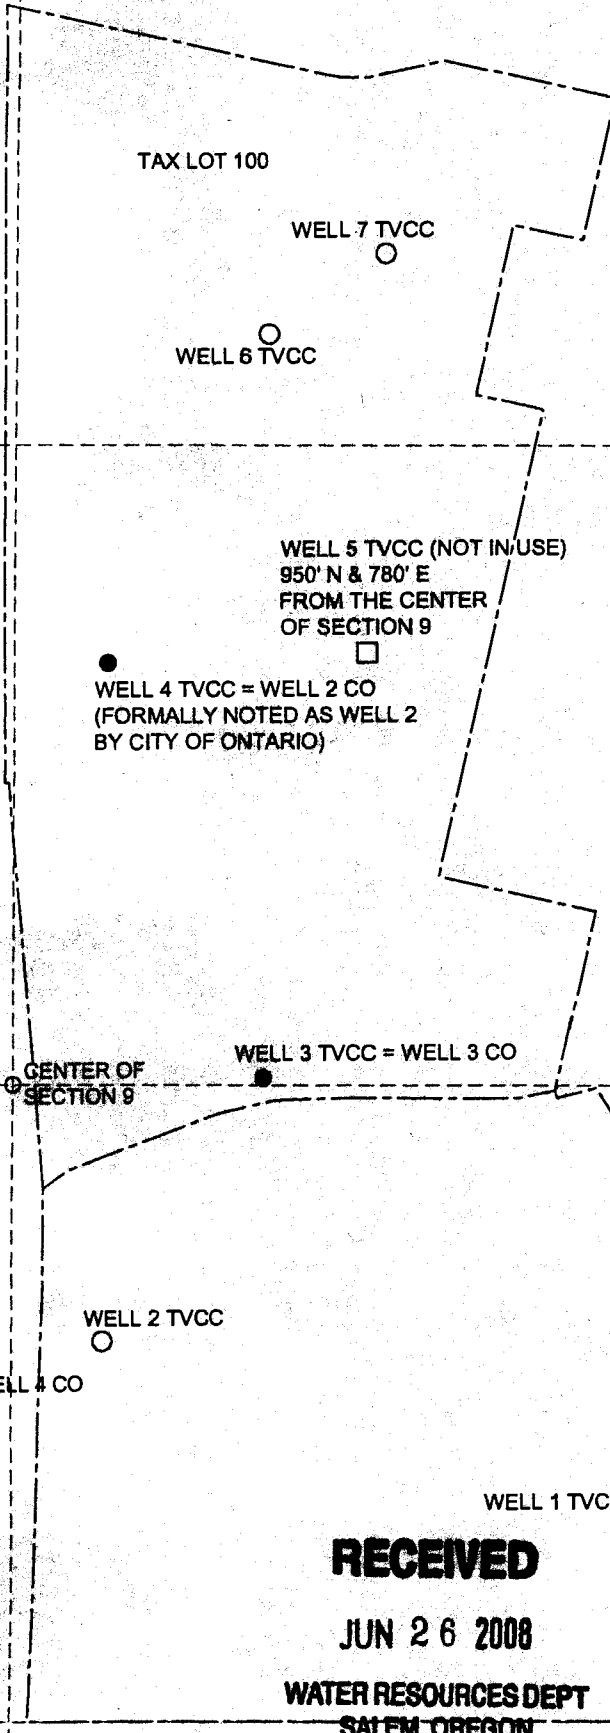

THIS IS FOR THE PURPOSE OF IDENTIFYING THE
LOCATION OF WATER RIGHTS ONLY AND IS NOT
INTENDED TO PROVIDE LEGAL DIMENSIONS OR
LOCATION OF PROPERTY LINES.

- AUTHORIZED POINTS OF APPROPRIATION:
- WELL 2 CO = WELL 4 TVCC: 920' N & 250' E
 - WELL 3 CO = WELL 3 TVCC: 30' N & 550' E
FROM THE CENTER OF SECTION 9
 - WELL 4 CO: NOT USED ON TVCC PROPERTY
LOCATED IN NE 1/4 SW 1/4 SECTION 9
IN EVERGREEN CEMETERY

- PROPOSED ADDITIONAL POINTS OF
APPROPRIATION: *8901*
- WELL 1: ~~980'~~ S & 1270' E
 - WELL 2: 510' S & 200' E
 - WELL 6: 1540' N & 560' E
 - WELL 7: 1680' N & 810' E
FROM THE CENTER OF SECTION 9

○ WELL 8 (NOT INCLUDED IN COBU
SEE ATTACHED LETTER)

TAX LOT 500

DATE: PR 071205
DRAWN BY: JEH
CHECKED BY: MEH
DATE: 1/22/07
DATE: 1/24/07

CLAIM OF BENEFICIAL USE MAP
TREASURE VALLEY COMMUNITY COLLEGE


HOLLADAY ENGINEERING CO.
ENGINEERS • CONSULTANTS
322 S. Main, P.O. Box 235, Rainier, ID 83461
(208) 336-3300 FAX (208) 842-2159
E-MAIL: holladay@holladayengineering.com



RECEIVED

JUN 26 2008

WATER RESOURCES DEPT
SALEM, OREGON


CLAIM OF BENEFICIAL USE MAP
 IN THE NAME OF:
TREASURE VALLEY COMMUNITY COLLEGE

T18S R47E SECTION 9 WM
IRRIGATED ACREAGE
TRANSFER NO T-9383
CERTIFICATE NO 22842
PERMIT NO U-226

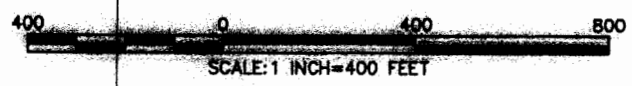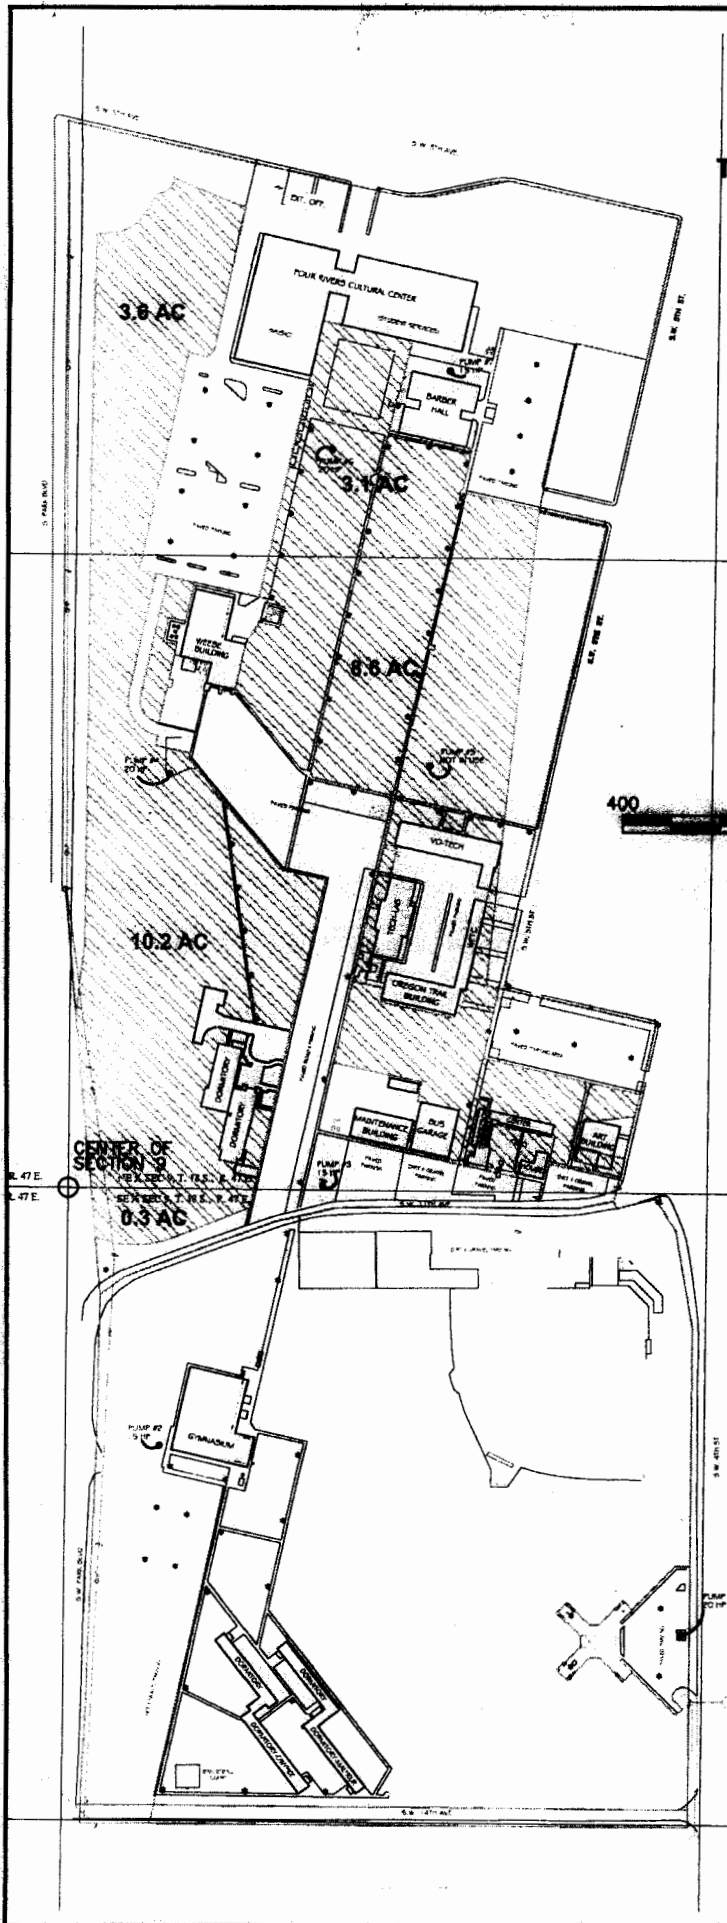

 **IRRIGATED AREAS**

THIS IS FOR THE PURPOSE
 OF IDENTIFYING THE
 LOCATION OF WATER
 RIGHTS ONLY AND IS NOT
 INTENDED TO PROVIDE
 LEGAL DIMENSIONS OR
 LOCATION OF PROPERTY
 LINES.

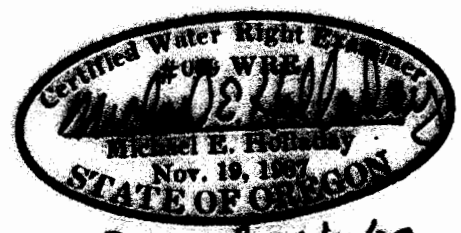

Renewal 06/30/09

REVISED 02/2008

RECEIVED

JUN 26 2008

WATER RESOURCES DEPT
SALEM, OREGON

G:\PR\071205\dwg\071205_REVISED