


Claim of Beneficial Use Points of Appropriation Transfer T-11342 (Cancelled Certificate 86245) Township 15 South, Range 13 East (W.M.)

RECEIVED
FEB 24 2014
SALES / OF

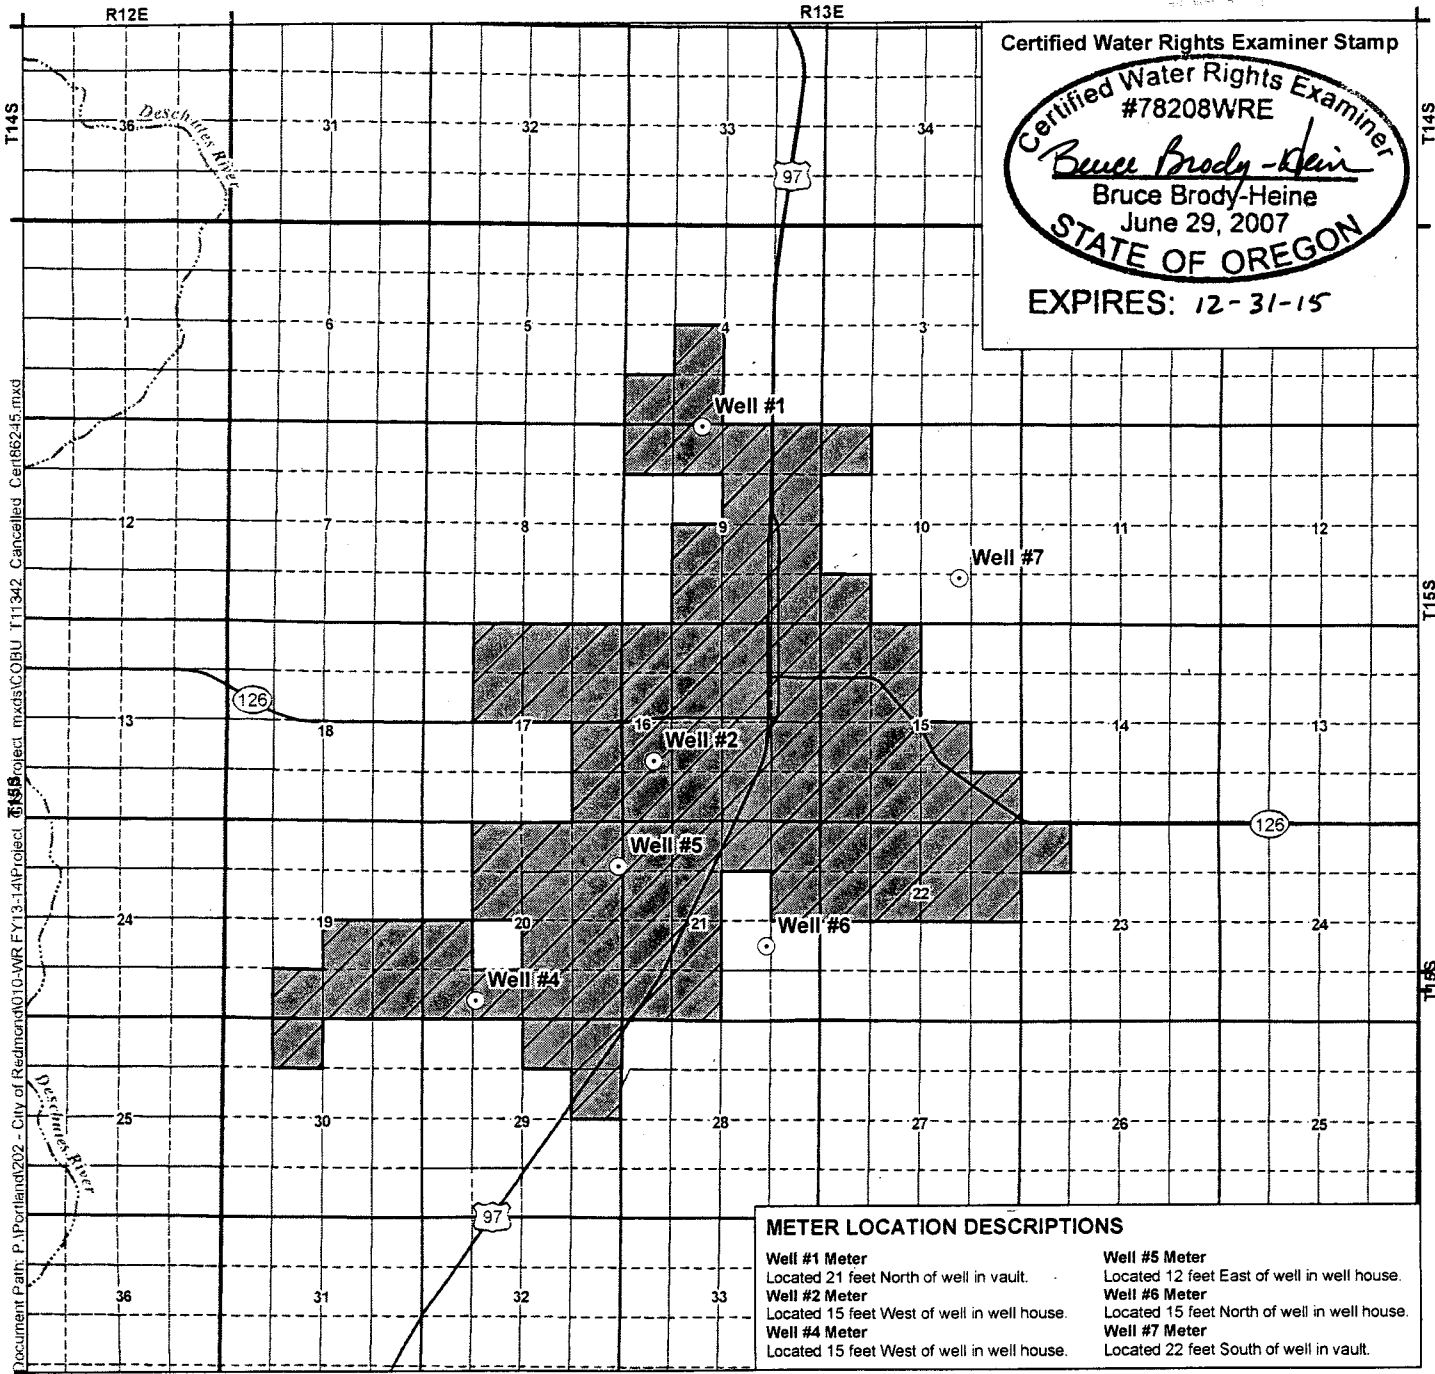

Document Path: P:\Portland\2012 - City of Redmond\10-WRR FY13-14\Project_11342 Cancelled Cert86245.mxd

METER LOCATION DESCRIPTIONS	
Well #1 Meter Located 21 feet North of well in vault.	Well #5 Meter Located 12 feet East of well in well house.
Well #2 Meter Located 15 feet West of well in well house.	Well #6 Meter Located 15 feet North of well in well house.
Well #4 Meter Located 15 feet West of well in well house.	Well #7 Meter Located 22 feet South of well in vault.

- LEGEND**
- Point of Appropriation (POA)
 - ▨ Place of Use (POU)

POA LOCATION DESCRIPTIONS

Well #1
NE1/4 NW1/4 Section 9, Township 15 South, Range 13 East (W.M.); South 83° 30' West; 546 feet from the North 1/4 Corner of Section 9

Well #2
NW1/4 SW1/4 Section 16, Township 15 South, Range 13 East (W.M.); North 27° 24' East; 1,800 feet from the SW Corner of Section 16

Well #4
SE1/4 SW1/4 Section 20, Township 15 South, Range 13 East (W.M.); North 82° 41' West; 3,945 feet from the SE Corner of Section 20

Well #5
NE1/4 NE1/4 Section 20, Township 15 South, Range 13 East (W.M.); South 5° 48' West; 1,200 feet from the NE Corner of Section 20

Well #6
NW1/4 SE1/4 Section 21, Township 15 South, Range 13 East (W.M.); North 35° 38' 4" West; 2,443.94 feet from the SE Corner of Section 21

Well #7
SW1/4 SE1/4 Section 10, Township 15 South, Range 13 East (W.M.); 1,210 feet North and 1,640 feet West from the SE Corner of Section 10

Disclaimer
This map was prepared for the purpose of identifying the location of a water right only and it is not intended to provide legal dimensions or location of property ownership lines.

Map Notes
Date: February 17, 2014
Data Sources: OWRD, OGIC, ESRI
Prepared By: GSI Water Solutions, Inc.

