


T.10S. R.5W. W.M.

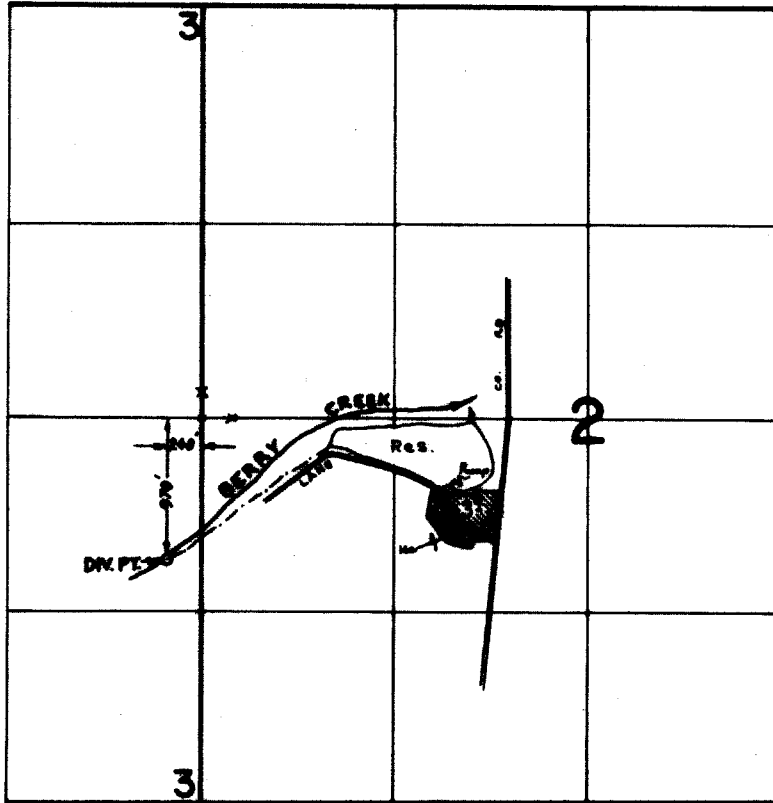

FINAL PROOF SURVEY
UNDER

Transfer No. 2454
47419 35533
Application No. R-47418 Permit No. R-5715
IN NAME OF

RALPH & OPAL KESTER

Surveyed MARCH 14, 1973, by R. MUCKEN