


SECTION

18

W 1/2 NE 1/4

Sec 18

TOWNSHIP 23 S, RANGE 6 E, W. M.

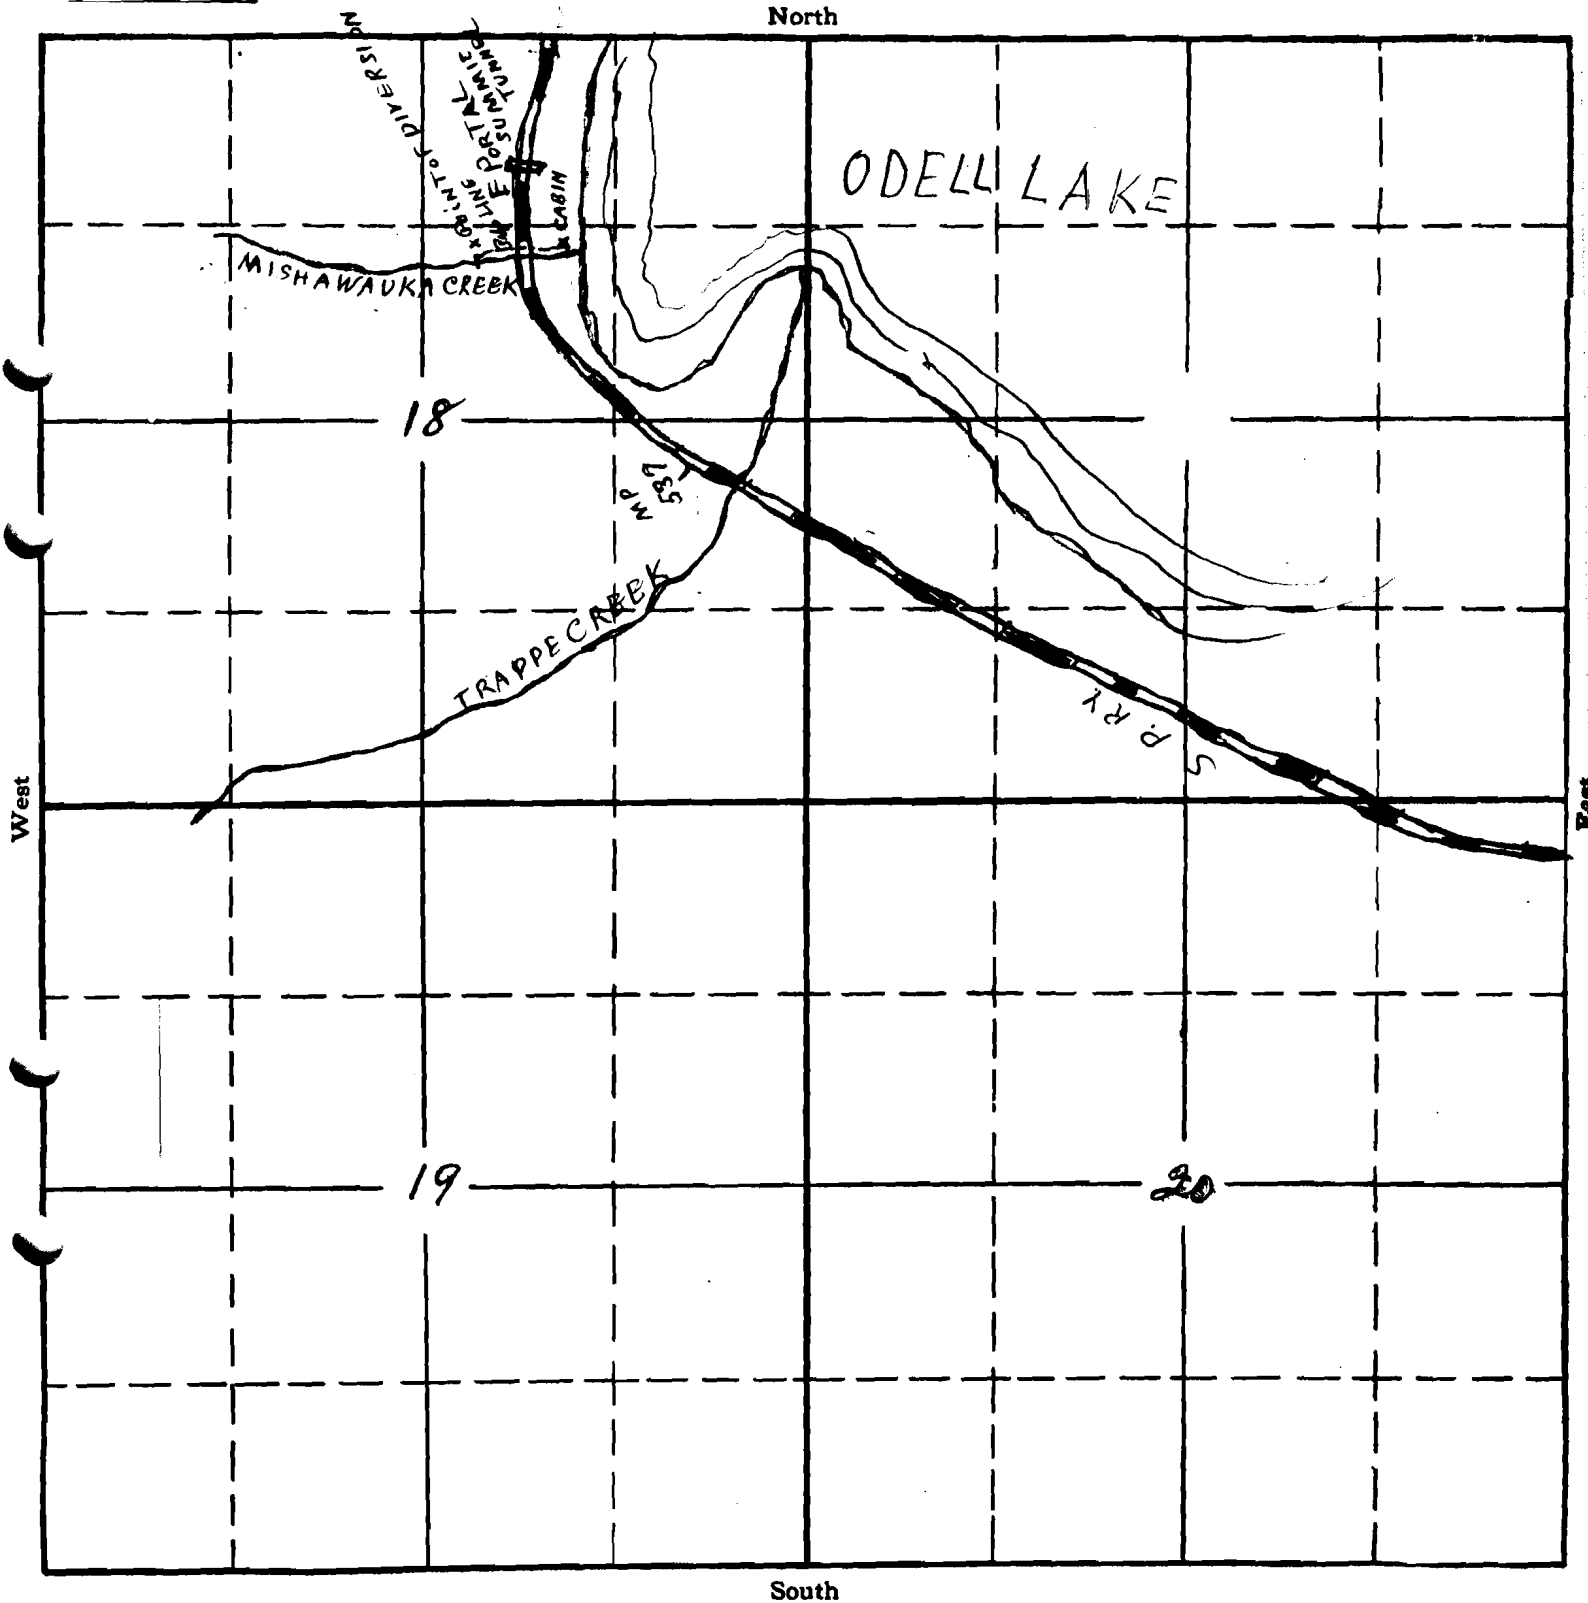

APPLICATION No. 13557

PERMIT No. 9700

C-8946

9700