

OCT 14 1997

FINAL PROOF SURVEY

APPLICATION NO. G-13410, PERMIT NO. G-12412
 APPLICATION NO. R-73392, PERMIT NO. R-11522

WATER RESOURCES DE
 SALEM, OREGON

IN THE NAME OF

WILLAMETTE INDUSTRIES, INC.
 BAUMAN DIVISION


LOCATED IN

SECTION 33, T.12S., R.1W., W.M.

SECTION 4, T.13S., R.1W., W.M.

LINN COUNTY, OREGON


SCALE: 1"=1320'-0"

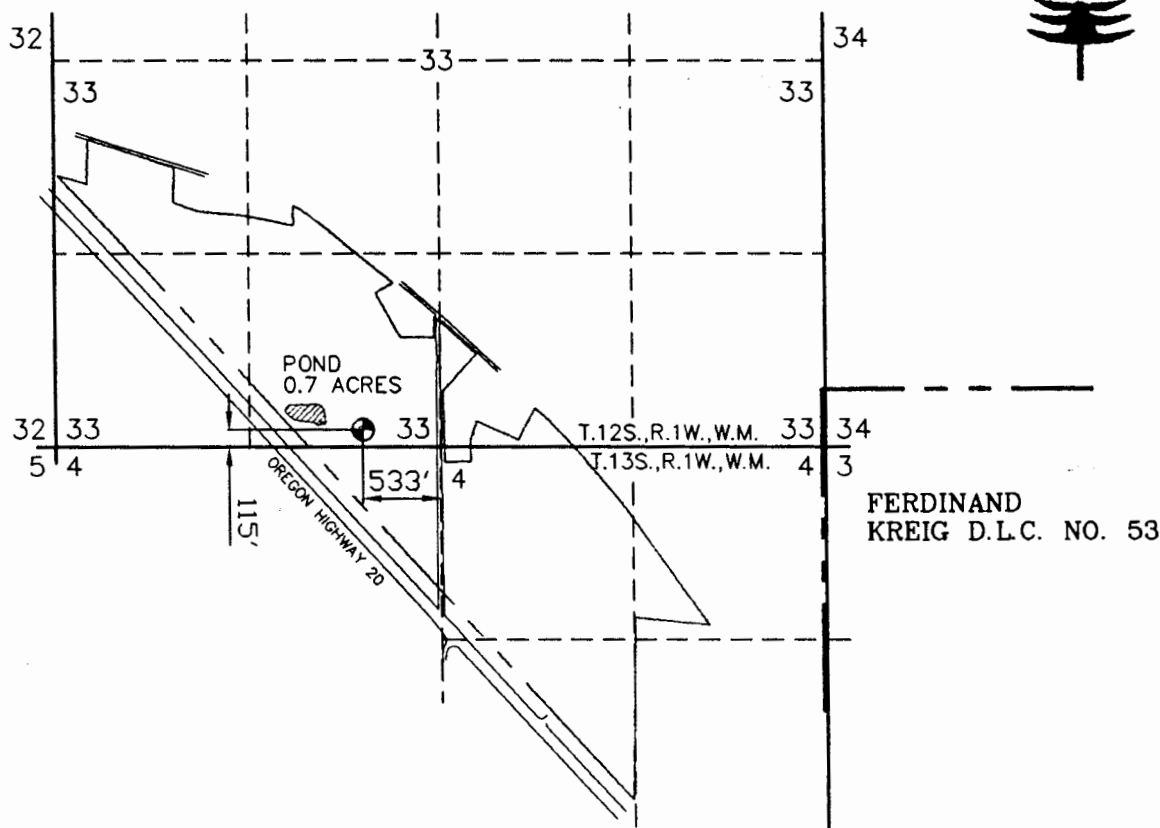LEGEND:

- = SECTION LINES
- - - - - = FORTY LINES
- = PROPERTY LINES
- - - - - = DONATION LAND CLAIM LINE
- ▨ = POND SITE
- ⊙ = WELL SITE

I J. EDWARD HENRICKS, BEING DULY SWORN AS A WATER RIGHT EXAMINER LICENSE NO. 170, HAVE PREPARED THIS MAP FOR WILLAMETTE INDUSTRIES, INC. ON THIS 15th DAY OF SEPTEMBER 1997. THE POND AREA HATCHED REPRESENTS THE ACREAGES TO BE MAINTAINED BY THIS APPLICATION.

PREPARATION OF THIS MAP IS FOR THE PURPOSE OF IDENTIFYING THE LOCATION OF THE WATER RIGHT ONLY AND HAS NO INTENT TO PROVIDE DIMENSIONS OR LOCATION OF PROPERTY OWNERSHIP LINES.

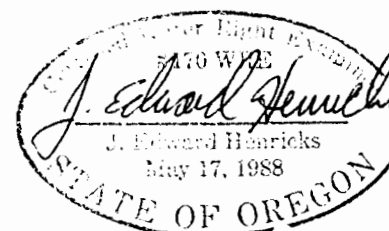

ONLY DOCUMENTS STAMPED WITH
 RED INK ARE ORIGINALS.

BFV-97-3159-P-02