


FINAL PROOF SURVEY
UNDER
APPLICATION NO. G-13411, PERMIT NO. G-12303
IN THE NAME OF
WILLAMETTE INDUSTRIES, INC.
LUMBER TECH
LOCATED IN
SECTION 14, T.12S., R.2W., W.M.
LINN COUNTY, OREGON
SCALE: 1"=1320'-0"

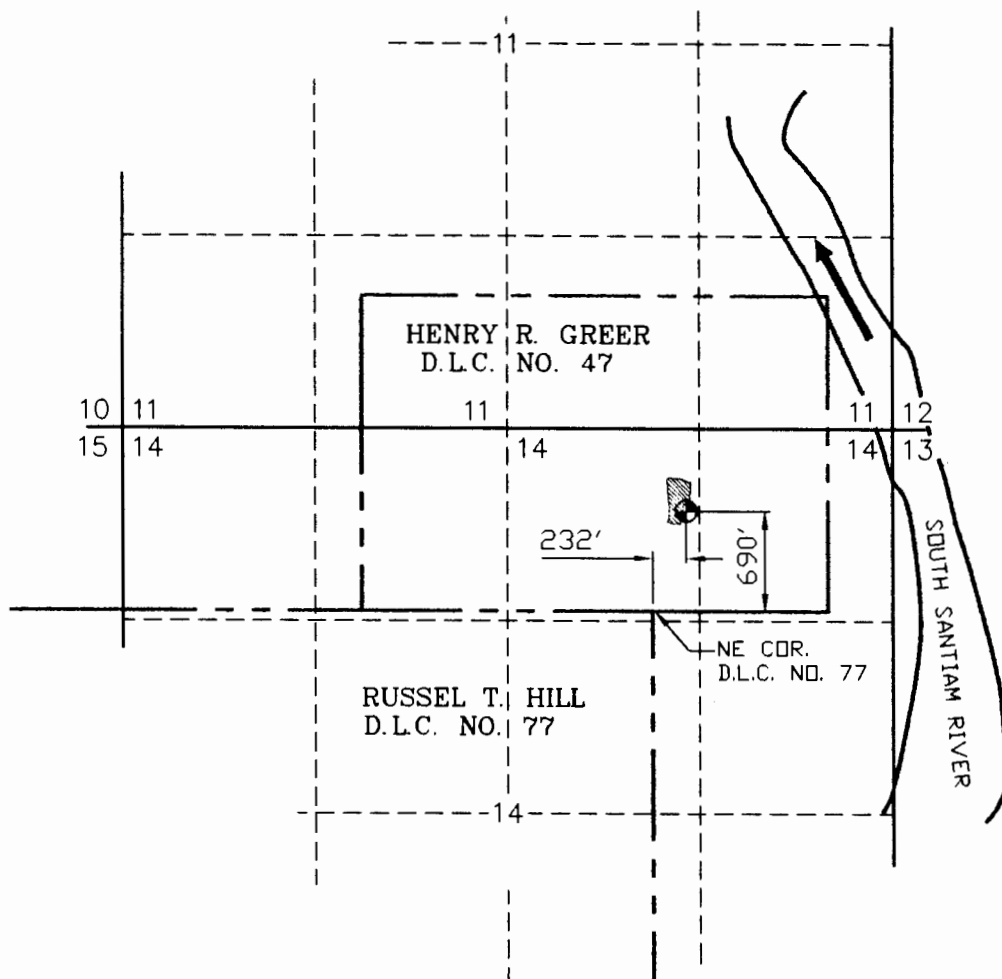

WATER RESOURCES DEPT.
SALEM, OREGON

OCT 13 1998


RECEIVED

LEGEND:

- = SECTION LINES
- - - - - = FORTY LINES
- . - . - = DONATION LAND CLAIM LINE
- ▨ = POND SITE
- = WELL SITE

I J. EDWARD HENRICKS, BEING DULY SWORN AS A WATER RIGHT EXAMINER LICENSE NO. 170, HAVE PREPARED THIS MAP FOR WILLAMETTE INDUSTRIES, INC. ON THIS 15 th DAY OF SEPTEMBER 1997. THE POND AREA HATCHED REPRESENTS THE ACREAGES TO BE MAINTAINED BY THIS APPLICATION.

PREPARATION OF THIS MAP IS FOR THE PURPOSE OF IDENTIFYING THE LOCATION OF THE WATER RIGHT ONLY AND HAS NO INTENT TO PROVIDE DIMENSIONS OR LOCATION OF PROPERTY OWNERSHIP LINES.

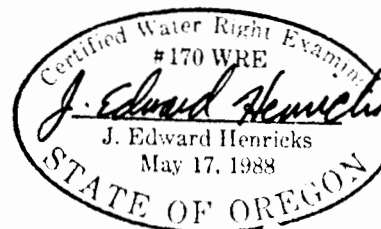

ONLY DOCUMENTS STAMPED WITH
RED INK ARE ORIGINALS.

BFV-97-3160-P-02