


RECEIVED

AUG 04 1999


WATER RESOURCES DEPT.
SALEM, OREGON

Scale: 1" = 400 ft.

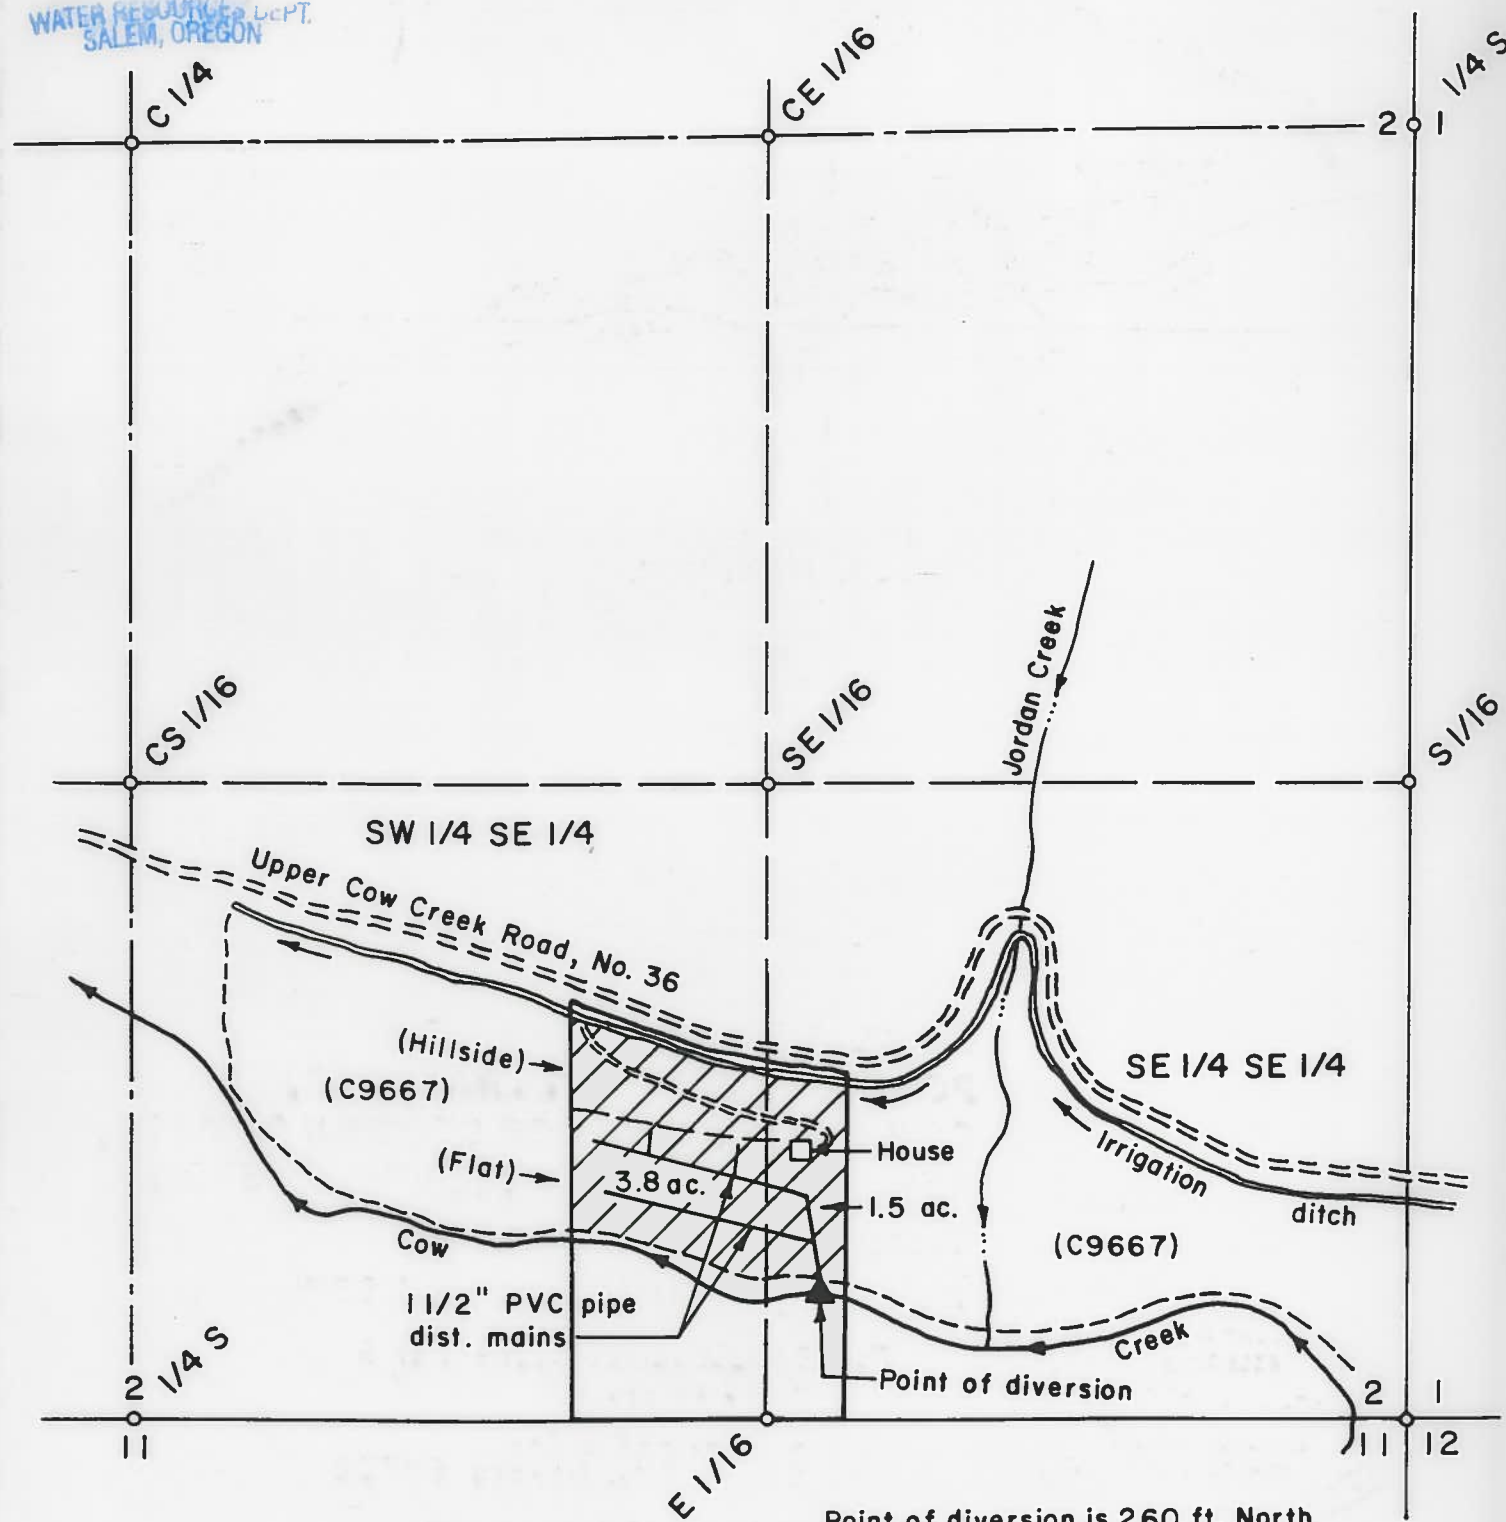

Point of diversion is 260 ft. North
& 1,420 ft. East of the south 1/4
corner of Section 2.

VICINITY MAP
Scale: 4" = 1 mile

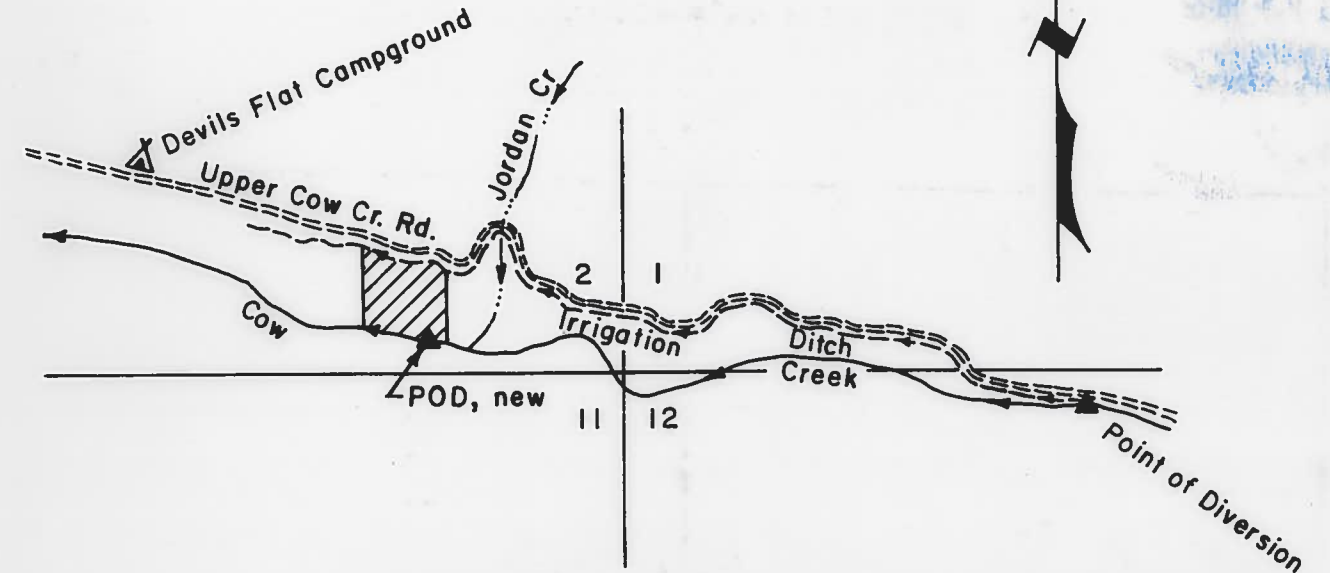

T32S, R3W, W.M.

FINAL PROOF SURVEY OF A
POINT OF DIVERSION TRANSFER,
COW CREEK, SE 1/4 OF SECTION 2, T32S,
R3W, W.M., DOUGLAS COUNTY, OREGON

Transfer No. 7694

Water Right Certificate No. 9667

For: Samuel James Noonkester &
Terry Strecker
210 E. Lee Street
Carson City, Nevada 89706

By: Shaner Engineering, Inc.
P.O. Box 1430
Roseburg, Oregon 97470



August 2, 1999