


**SCALE: 1"=1320'**

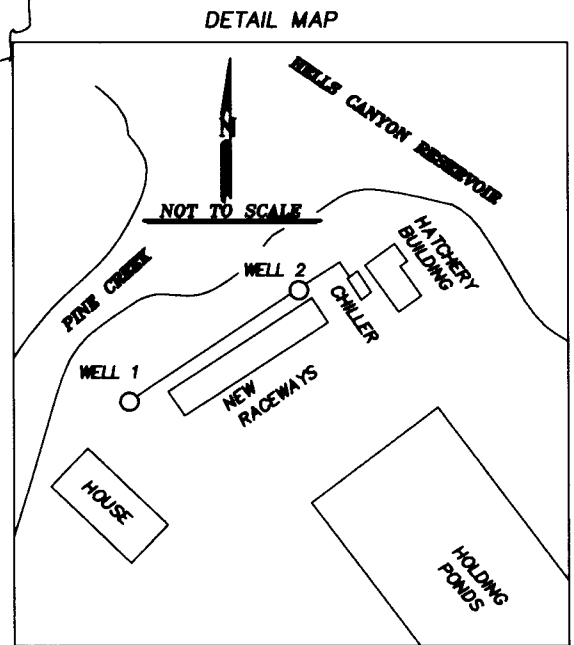

Certified Water Right Examiner  
# 114  
*Nick G. Robinson*  
Rick G. Robinson  
Nov. 19, 1987  
STATE OF OREGON

**FINAL PROOF MAP OF WATER RIGHTS FROM WELL #1 AND WELL #2**

FOR

**IDAHO POWER COMPANY**

NOVEMBER 3, 2000

BAGETT-GRIFFITH & BLACKMAN

2006 Adams Avenue

LAGRANDE OREGON 97850

NOTE: The preparation of this map was for the purpose of identifying the location of the proposed water right and has no intent to provide dimensions or location of property ownership lines. Location information shown hereon was furnished by the applicant.

**RECEIVED**

NOV 10 2000

WATER RESOURCES DIVISION  
SALEM, OREGON

APPLICATION NO. G-12886  
PERMIT NO. G-12778