



NW 1/4 OF THE NW 1/4 OF SECTION 4
NE 1/4 OF THE NW 1/4 OF SECTION 4
T5S, R1E of the WM
CLACKAMAS COUNTY, OREGON

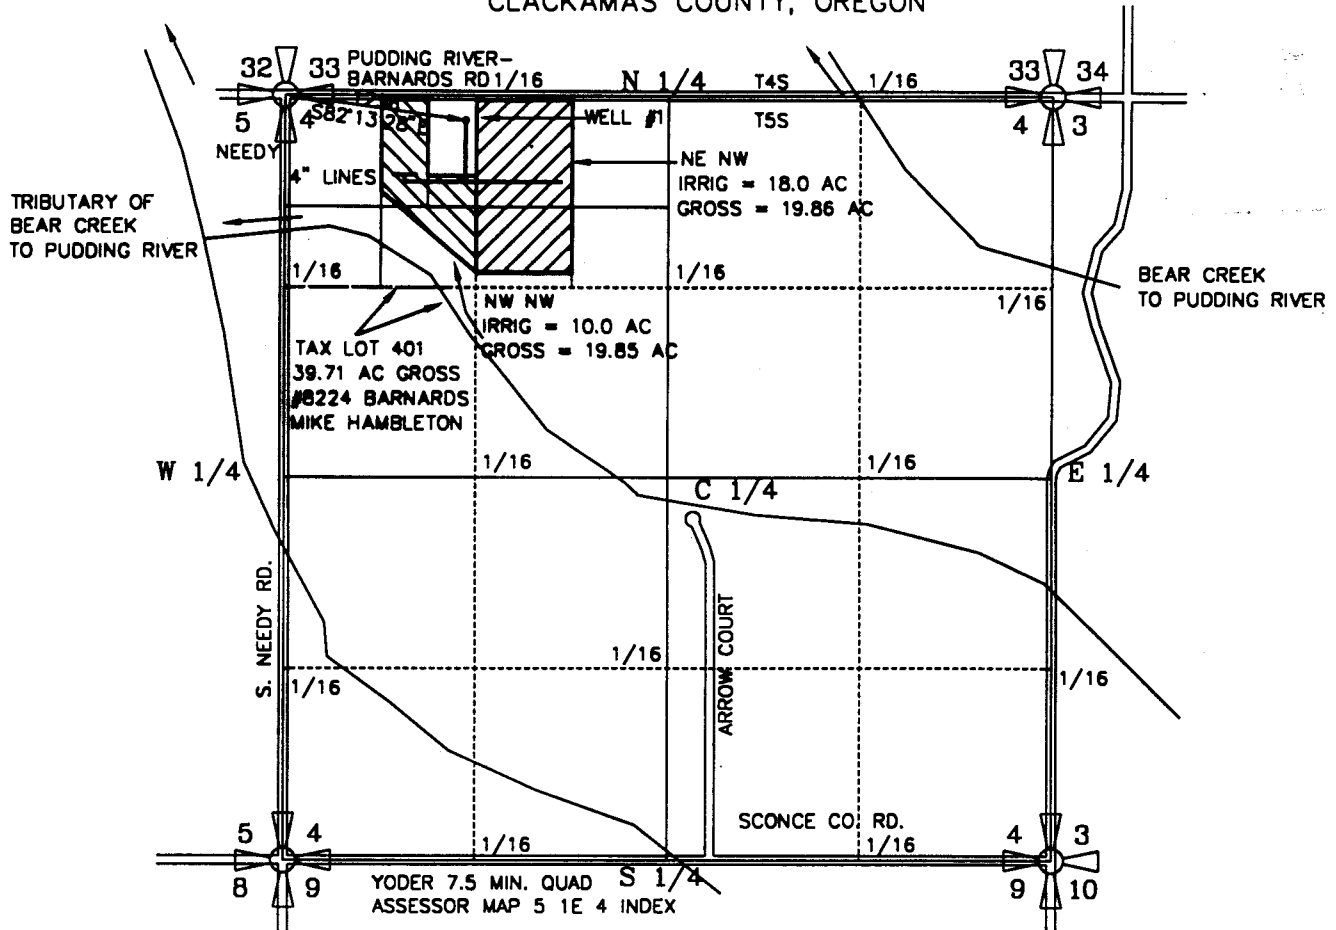

PREPARATION OF THIS MAP WAS FOR THE PURPOSE
OF IDENTIFYING THE LOCATION OF THE WATER RIGHTS
ONLY AND HAS NO INTENT TO PROVIDE DIMENSIONS
OR LOCATION OF PROPERTY OWNERSHIP LINES.


IRRIGATION LOCATION	IRRIGATION AREA:
NE 1/4 OF NW 1/4 SEC. 4	18.0/ACRES
NW 1/4 OF NW 1/4 SEC. 4	10.0 ACRES
TOTAL IRRIGATED ACRES	= 28.0 ACRES

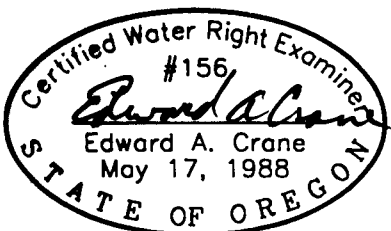

Renewal 12/31/01
Signed S-77-2000

SURVEYED MAY 2, 2000
BY EDWARD A. CRANE, CWRE

HA/CAD/CWRE/121-009/12100801.DWG EAC 5/22/2000

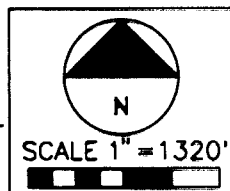

WELL #1 IS LOCATED 170 FEET SOUTH AND 1245 FEET EAST OF
THE NORTHWEST CORNER OF SECTION 4, TOWNSHIP 5 SOUTH,
RANGE 1 EAST, WILLAMETTE MERIDIAN, CLACKAMAS COUNTY, OREGON

FINAL PROOF SURVEY GROUNDWATER PERMIT G-12405

PREPARED BY EDWARD A. CRANE, CWRE

DATE
MAY 2000

PROJECT NO.
121-009



CRANE & MERSETH
Engineering/Surveying
SUITE "D"
6566 SE LAKE ROAD
MILWAUKIE, OREGON 97222
BUS: (503) 654-2005
FAX: (503) 654-2575

APPLICATION FOR PERMIT NUMBER G-13340
PERMIT NUMBER G-12405 IN THE NAME OF:

COLONY NURSERY, INC. - MIKE HAMBLETON
28889 S NEEDY ROAD, CANBY OR 97013
TEL: 503-651-2348; FAX: 503-651-2524

SHEET
1/1