


# T.5S., R.2W., W.M.

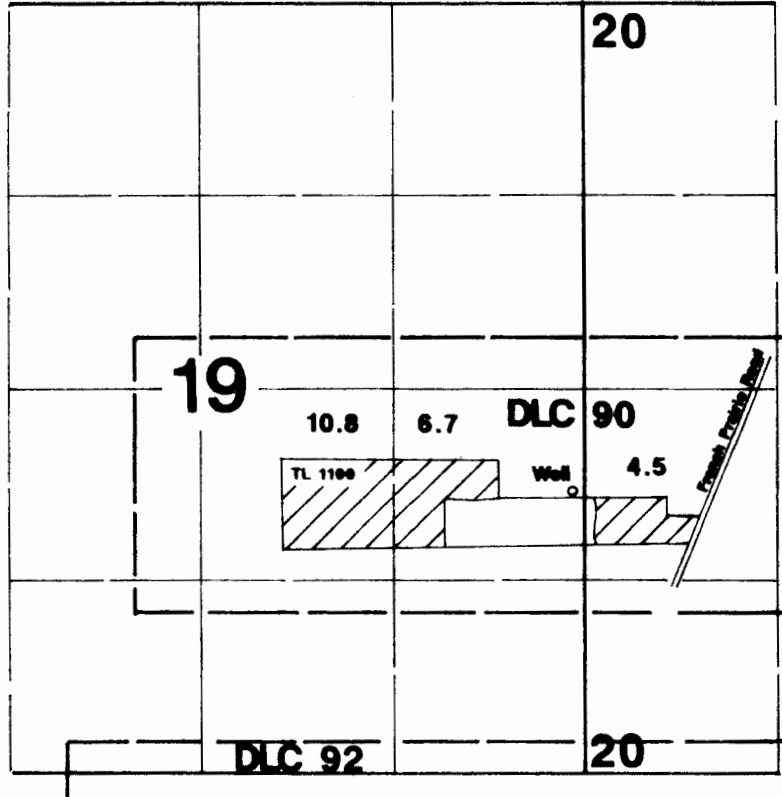

Well is located 1946' N & 70' W from the SE corner of Section 19.

## Final Proof Survey

In Name Of

**D. A. Nusom Orchards Inc.**

Application #: G-14582

Permit #: G-15378

Surveyed on September 6, 2003 by JM Schuette

This Map Was Prepared For The Purpose Of Identifying The Location Of A Water Right Only And Is Not Intended To Provide Legal Dimensions Or Location Of Property Ownership Lines.

