


**RECEIVED**

SEP 28 2000

WATER RESOURCES DEPT.  
SALEM, OREGON

**FINAL PROOF MAP FOR  
PERMIT NO. G-12744  
APPLICATION NO. G-13838  
SUPPLEMENTAL WATER RIGHT  
FOR MICHAEL & JAMIE VAVRINEC**

In The NW 1/4 of Section 17,  
Township 15 South, Range 11 East,  
W.M., Deschutes County, Oregon

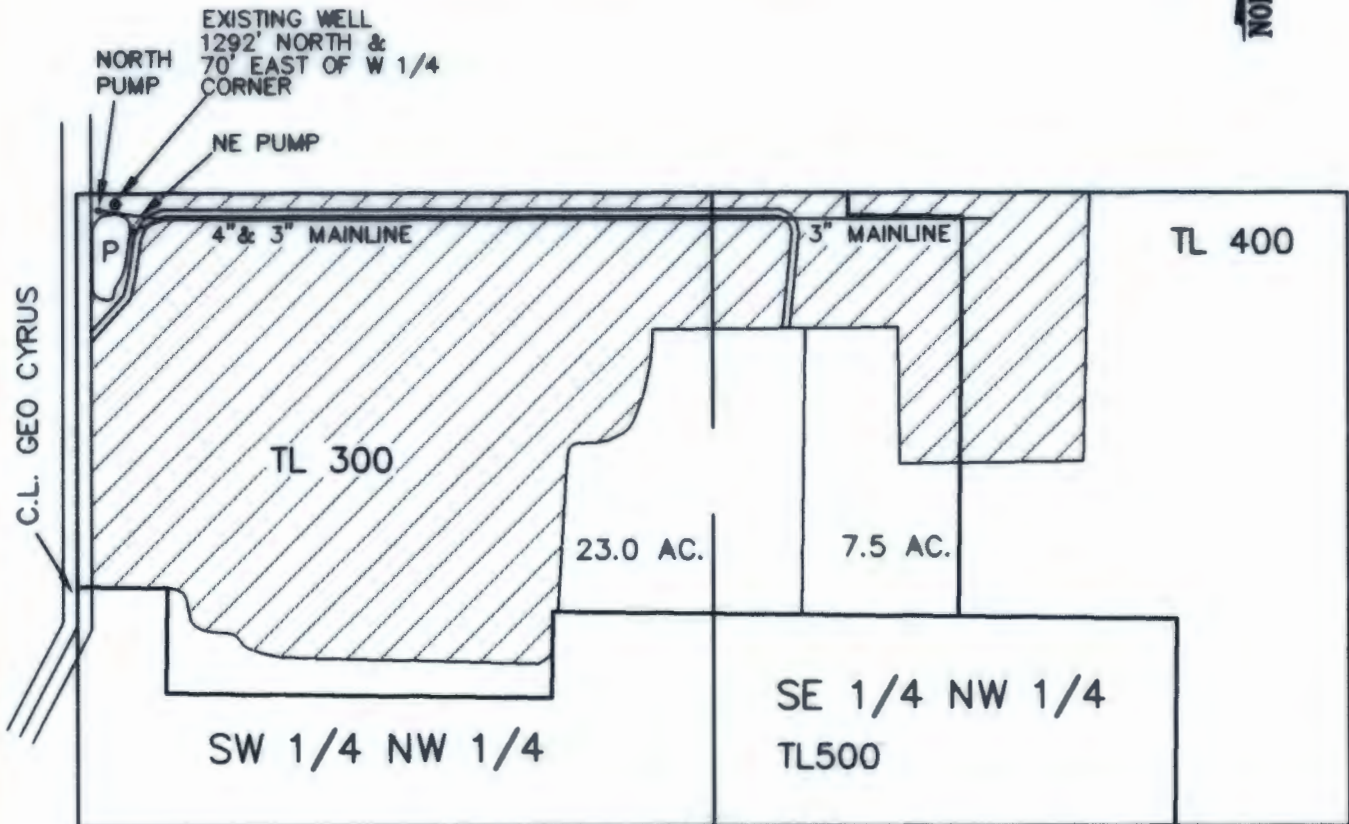


W 1/4 CORNER

= Supplemental Water Rights

I, James R. Tye, Certified Water Right Examiner in the State of Oregon, hereby certify that this water rights survey map was prepared under my direct supervision.

The preparation of this map is for the purpose of identifying the location of the water right only and has no intent to provide dimensions or locations of property ownership lines.

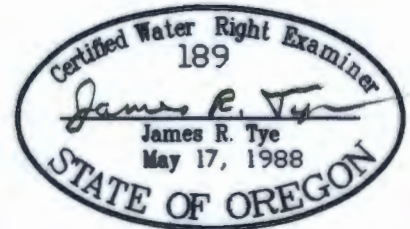

SCALE 1"=400' | DATE 9-21-00 | SURVEY BY AERIAL | DRAWN BY S.R.K. | ORDER NO. 2975-22C

**SUN COUNTRY ENGINEERING & SURVEYING, INC.**  
920 SE ARMOUR ROAD BEND, OREGON 97702 PHONE 382-8882