


# T.4 & 5 S. R. 3 W. W.M.

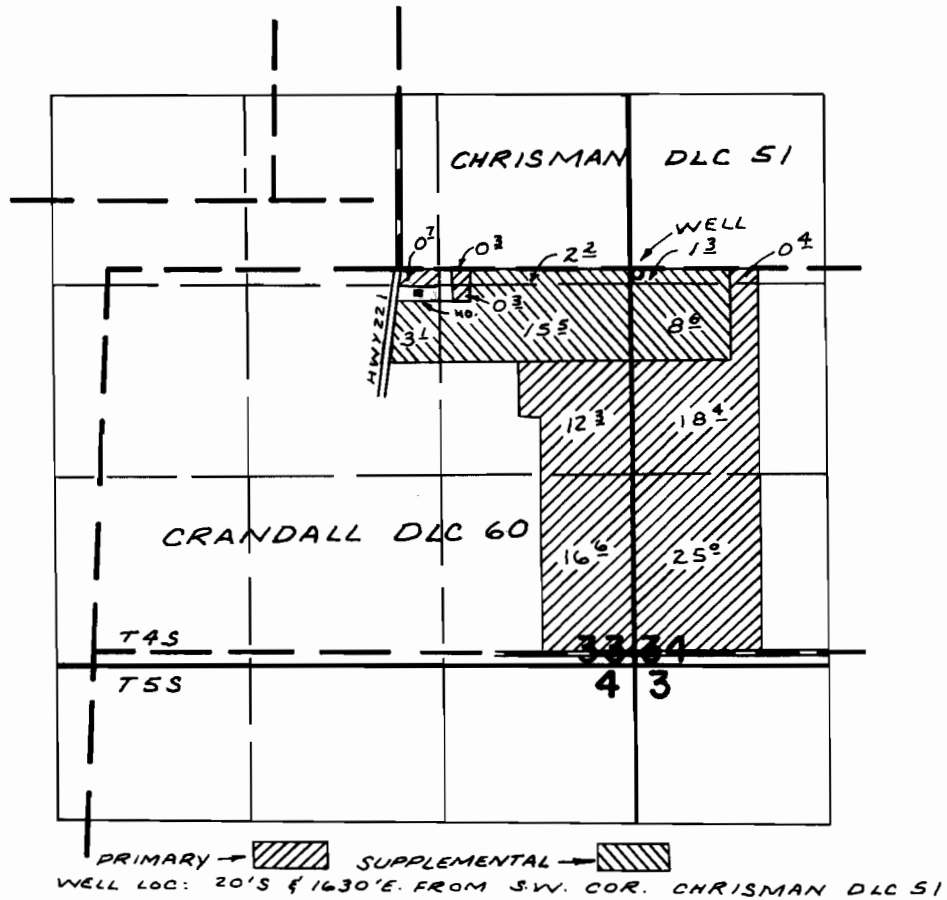

## FINAL PROOF SURVEY UNDER

Application No. G-3364 Permit No. G-3154  
IN NAME OF

GRAY & COMPANY

Surveyed Nov. 9, 1972, by R. MUCKEN