



T. 4 S., R. 3 W., W.M.

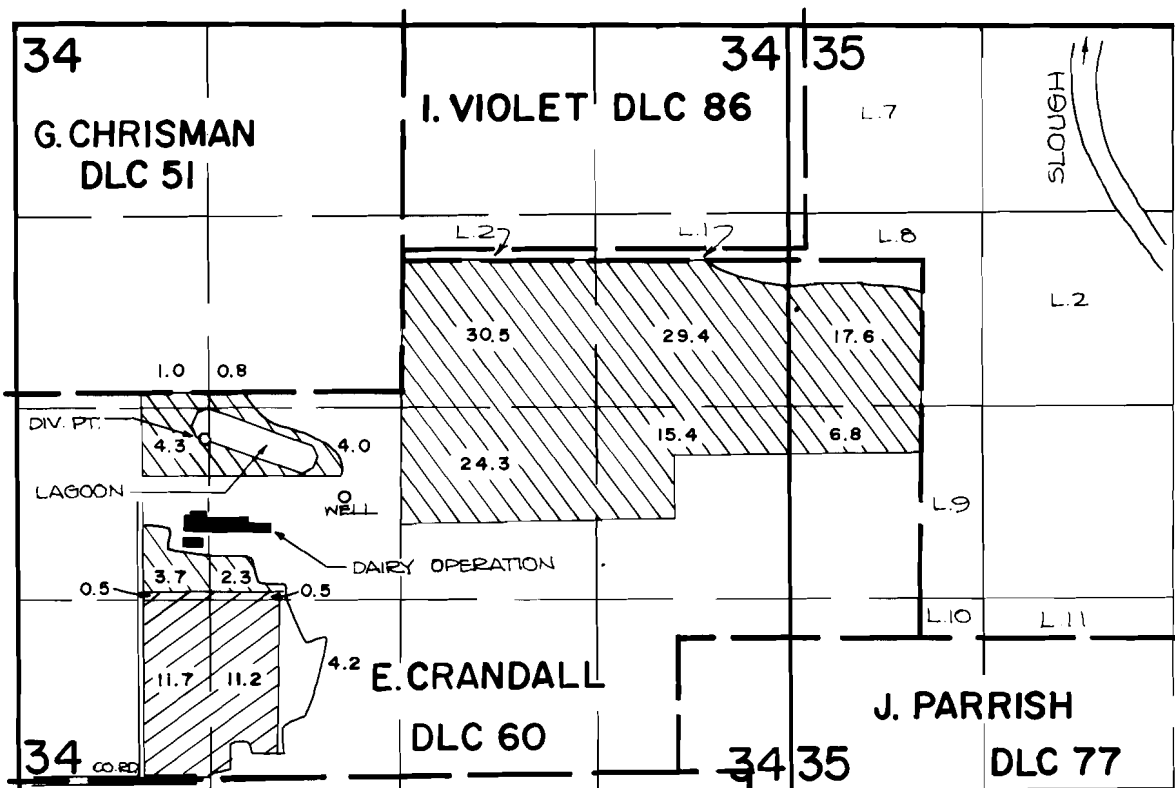

THE WELL IS LOCATED 2025 FT. N. AND 2280 FT. E. FROM THE S.W. CORNER OF SECTION 34.
THE DIV. PT. IS LOCATED 2450 FT. N. AND 1300 FT. E. FROM THE S.W. CORNER OF SECTION 34.



PRIMARY
SUPPLEMENTAL

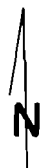

FINAL PROOF SURVEY UNDER

SCALE: 4" = 1 MILE

55764

41510

R-55763

R-6572

Application No. G-8075 Permit No. G-7472

IN NAME OF

SLEGERS FARMS, INC.

Surveyed MAY 15, 1984, by P. Pagan