

Claim of Beneficial Use



APPLICATION No. G-13883

PERMIT No. G-12801

Sections 3 & 10, T20^SN, R46E, WM

TAX LOT No. 20 46A 2000 & 2002 - MALHEUR COUNTY

FOR: Doug Pfeiler
2857 Heritage Drive
Nyssa, OR 97913

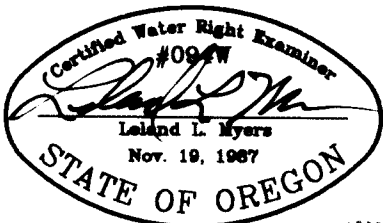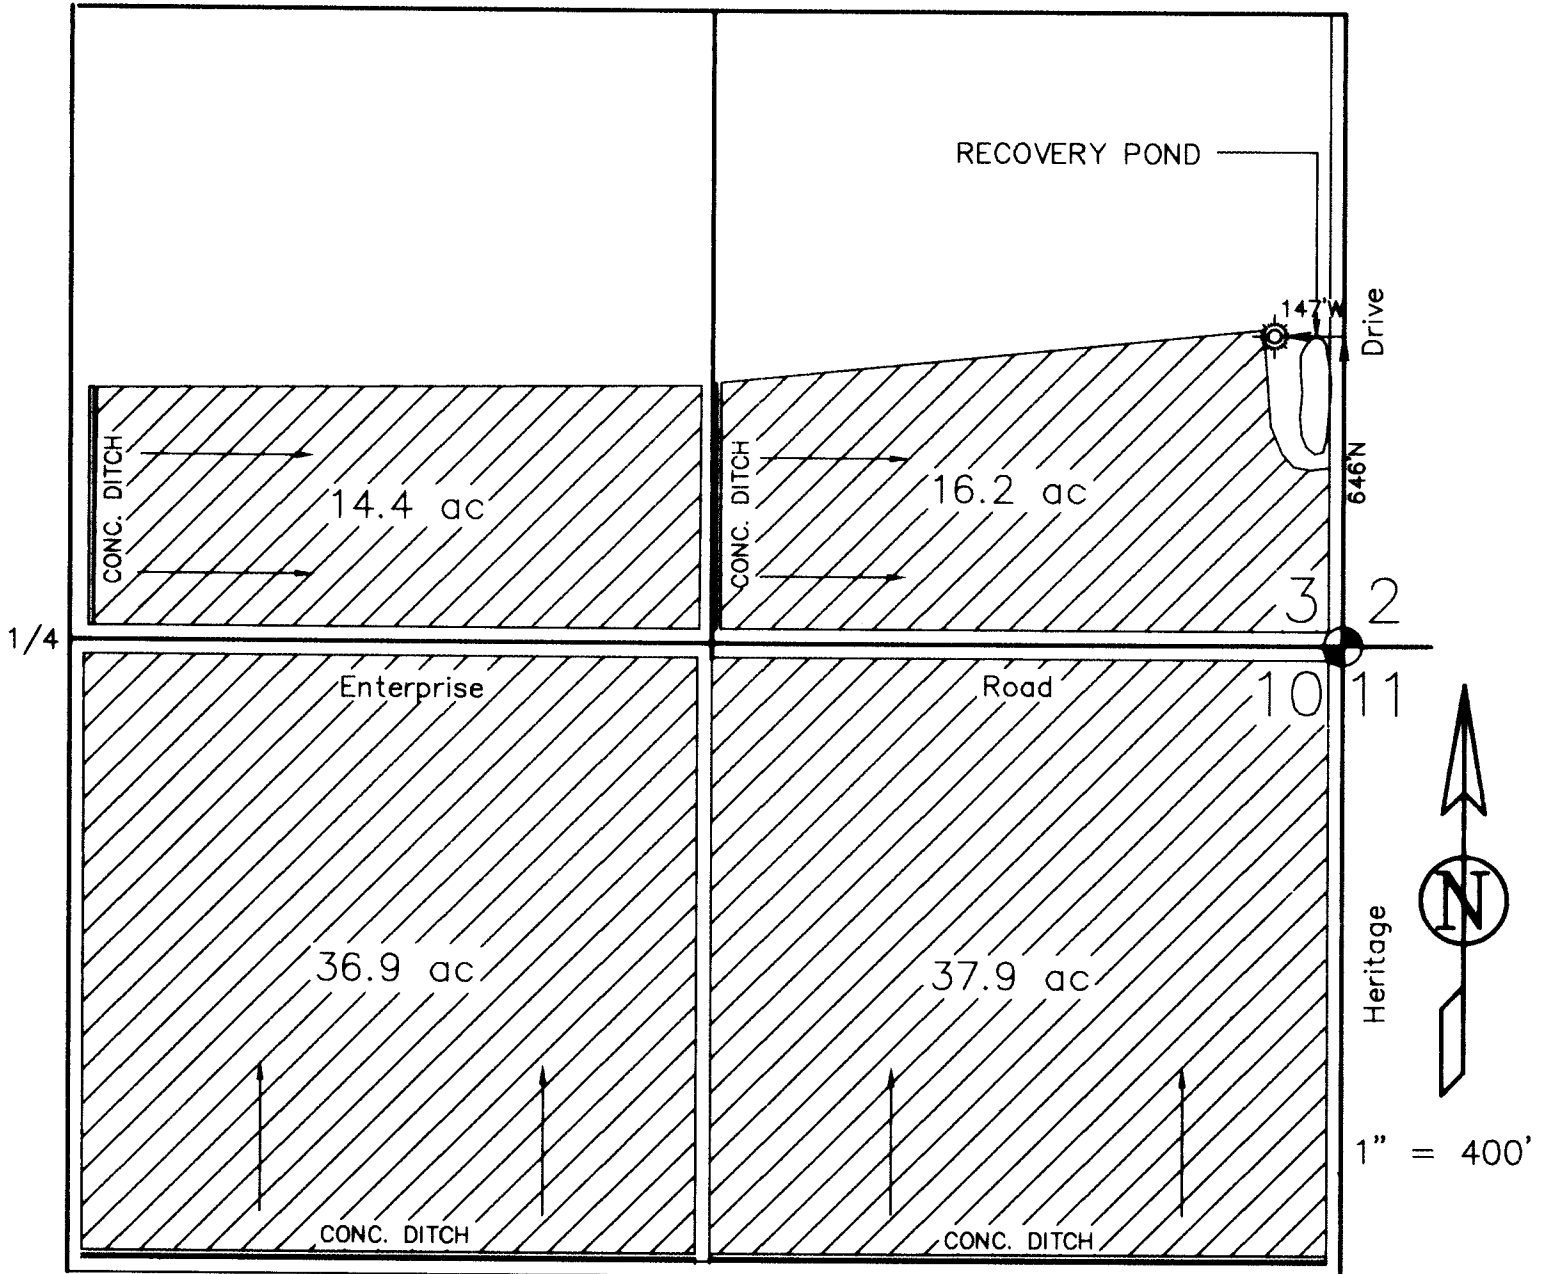

RECEIVED

SEP 29 2000

WATER RESOURCES DEPT.
SALEM, OREGON

This map is for the purpose of identifying the location of the water right only and has no intent to provide dimensions or location of property ownership lines.

Updated Township to 20^S. MB/wro