

RECEIVED

AUG 04 2000

WATER RESOURCES DEPT.
SALEM, OREGON

SE1/4, SE1/4

SE1/4, SW1/4

FND BCIP

2 1

POINT OF DIVERSION

199 FEET SOUTH
152 FEET WEST
OF SE CORNER
SECTION 2

11 12

← ROGUE RIVER

NE1/4, NE1/4

NW1/4, NW1/4

THE PREPARATION OF THIS MAP WAS FOR THE PURPOSE OF IDENTIFYING
THE LOCATION OF THE PROPOSED WATER RIGHT AND HAS NO INTENT TO
PROVIDE DIMENSIONS OR LOCATION OF PROPERTY LINES.

SECTIONS 1, 2, 11 & 12

T. 36 S., R. 14 W., W. M.

FINAL PROOF SURVEY

UNDER

APPLICATION #G-12896 PERMIT #G-12641


IN THE NAME OF

LUCKY LODGE TRAILER PARK



1" = 400'

BRYAN FLAVIN LAND SURVEYING
BRYAN M. FLAVIN
REGISTERED LAND SURVEYOR
SPECIAL DISTRICT EXAMINER
SPECIAL DISTRICT EXAMINER
FIELD OFFICE, SALEM, OREGON 97444
541-247-8485
CWRE #366

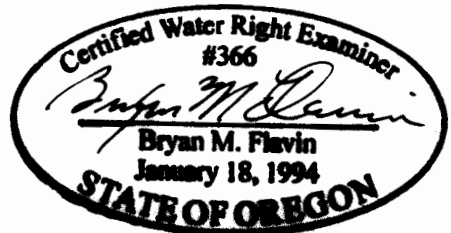

SURVEYED MAY 18, 2000 BY BRYAN M. FLAVIN