


Lands with primary water rights from a well.



Mainlines

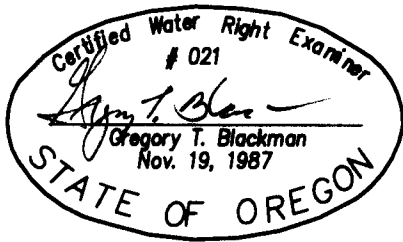

NOTE: The preparation of this map was for the purpose of identifying the location of the proposed water right and has no intent to provide dimensions or location of property ownership lines. Location information shown hereon was furnished by the applicant.

24 19 RECEIVED

JUN 28 2004

WATER RESOURCES DEPT
SALEM, OREGON

June 18, 2004

*FINAL PROOF MAP OF
WATER RIGHTS FROM A
WELL*

FOR

*ELWYN & GREG BINGAMAN
BY*

*BAGETT - GRIFFITH & BLACKMAN
2006 ADAMS AVENUE
LAGRANDE, OREGON 97850*

APPLICATION NO. G- 15919

PERMIT NUMBER G- 15504