


Instream Transfer Application Map - Certificate 10901 Authorized Place of Use and Point of Diversion

Township 33 South, Range 6 East (W.M.)

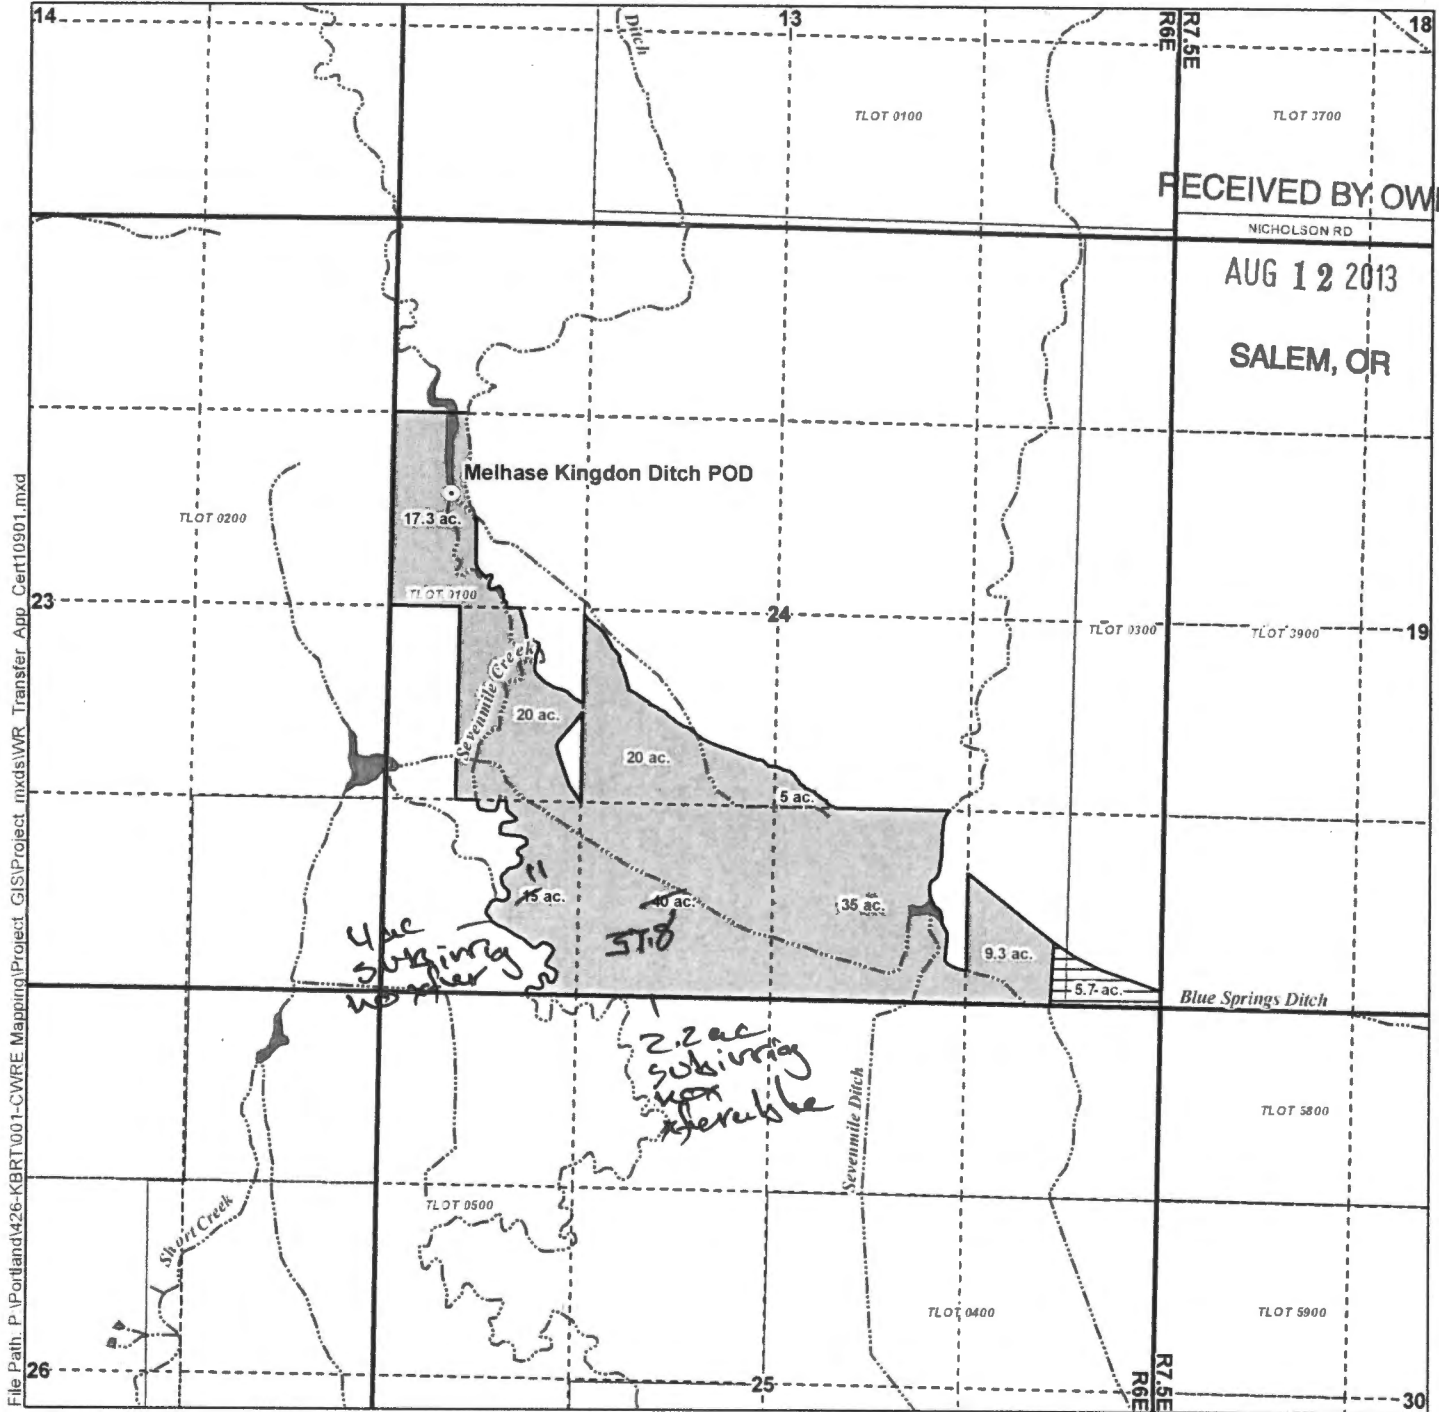

RECEIVED BY: OWRD
NICHOLSON RD
AUG 12 2013
SALEM, OR

File Path: P:\Portland\426-KBRT\001-CWRE Mapping\Project_GIS\Project_mxd\WR_Transfer_App_Cert10901.mxd


LEGEND

- Authorized Place of Use (POU) to be Transferred
- Authorized POU Remaining
- Authorized Point of Diversion (POD)
- Tax Lots
- Waterbodies
- Watercourses

POD Location Description

Melhase Kingdon Ditch POD
Located 1.875 feet South and 390 feet East from the NW corner of Section 24. Township 33 South, Range 6 East (W.M.)

Certified Water Rights Examiner Stamp

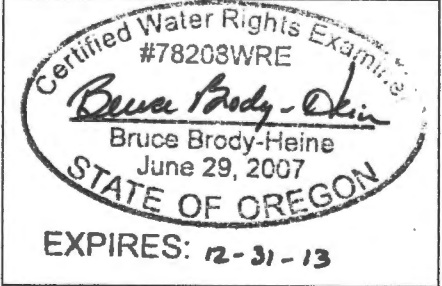

Disclaimer
This map was prepared for the purpose of identifying the location of a water right only and it is not intended to provide legal dimensions or location of property ownership lines.

Map Notes
Date: July 22, 2013
Data Sources: OWRD, OGIC, USGS, Klamath County GIS
Prepared By: GSI Water Solutions, Inc

