



0 660 1,320 2,640 3,960 5,280 Feet

1" = 1320'

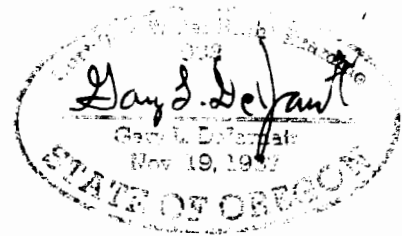

# T 15 S, R 40 E, WM MALHEUR COUNTY, OREGON

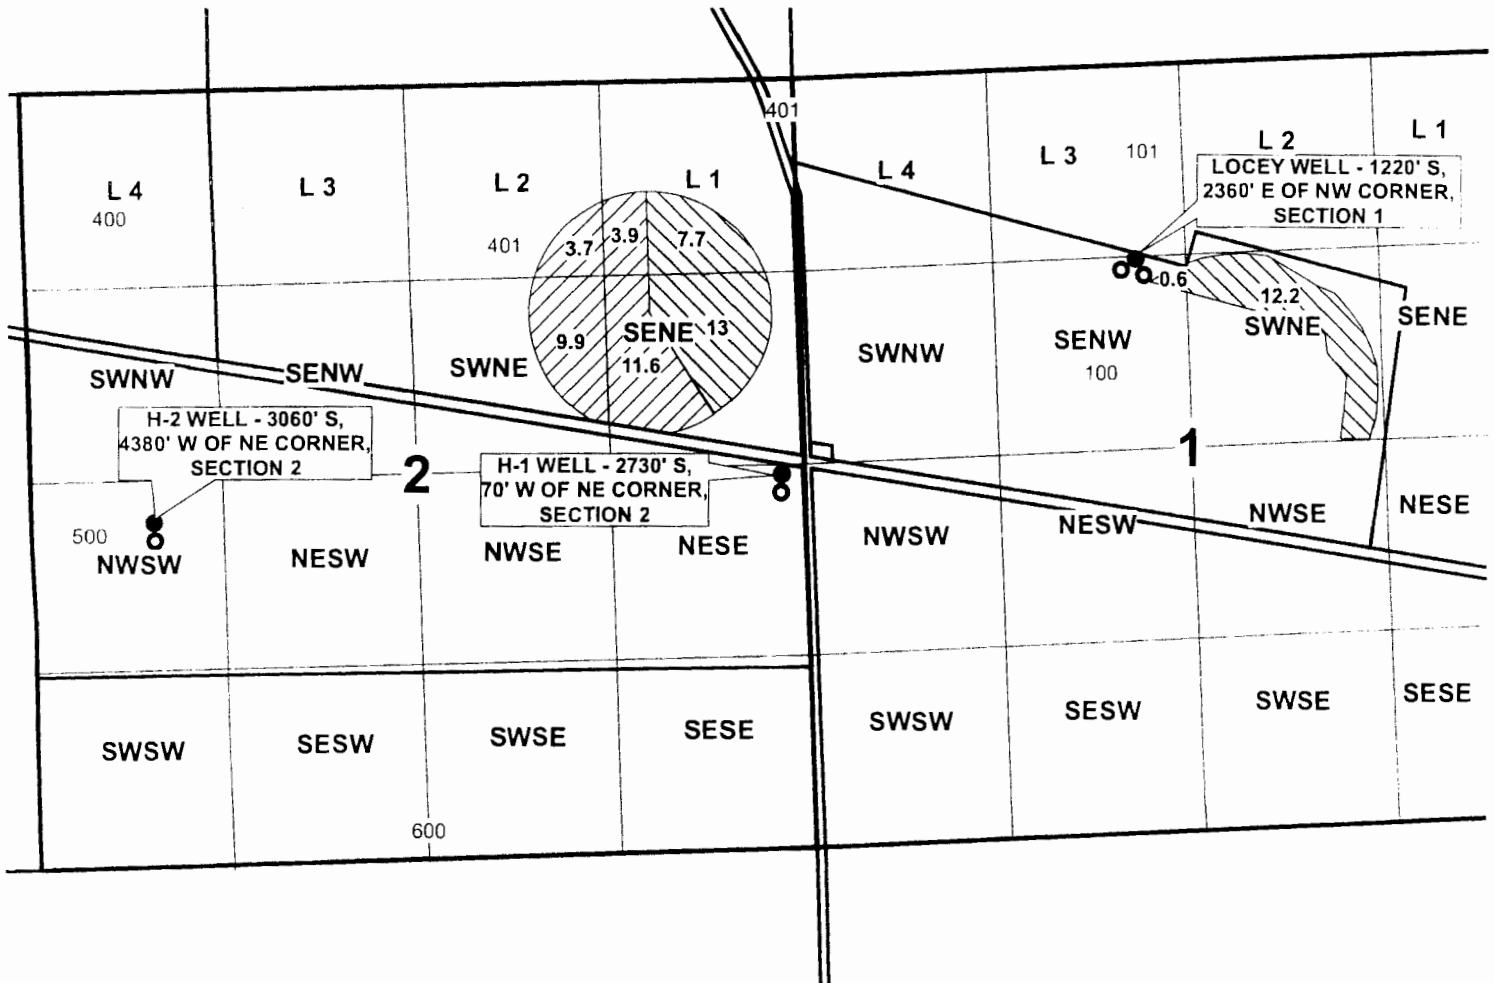

RENEWAL DATE 12-31-2015

- WELLS
- METERS
- TAX LOT BOUNDARIES
- ▨ NOVEMBER 5, 1951 IRRIGATION POU BY QQ
- ▩ MARCH 30, 1954 IRRIGATION POU BY QQ



**CLAIM OF BENEFICIAL USE MAP  
FOR COW VALLEY RANCH  
TRANSFER T-11588 JOB # 14018**

This map is not intended  
to provide legal dimensions  
or locations of property  
ownership lines.  
JUNE 13, 2014

**WATER RIGHT SERVICES, LLC**  
PO BOX 1830, BEND, OR 97709  
**WWW.OREGONWATER.US CCB # 197121**  
johnshort@usa.com 541-389-2837