


0 660 1,320 2,640 3,960 5,280 Feet

1" = 1320'



T 15 S, R 40 E, WM

MALHEUR COUNTY, OREGON

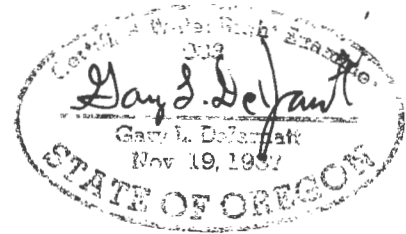

RENEWAL DATE 12-31-2015



- WELLS
- METERS

□ TAX LOT BOUNDARIES

▨ NOVEMBER 5, 1951 IRRIGATION POU BY QQ

▨ MARCH 30, 1954 IRRIGATION POU BY QQ

**CLAIM OF BENEFICIAL USE MAP
FOR COW VALLEY RANCH
TRANSFER T-11588 JOB # 14018**

This map is not intended to provide legal dimensions or locations of property ownership lines.
JUNE 13, 2014

WATER RIGHT SERVICES, LLC
PO BOX 1830, BEND, OR 97709
WWW.OREGONWATER.US CCB # 197121
johnshort@usa.com 541-389-2837