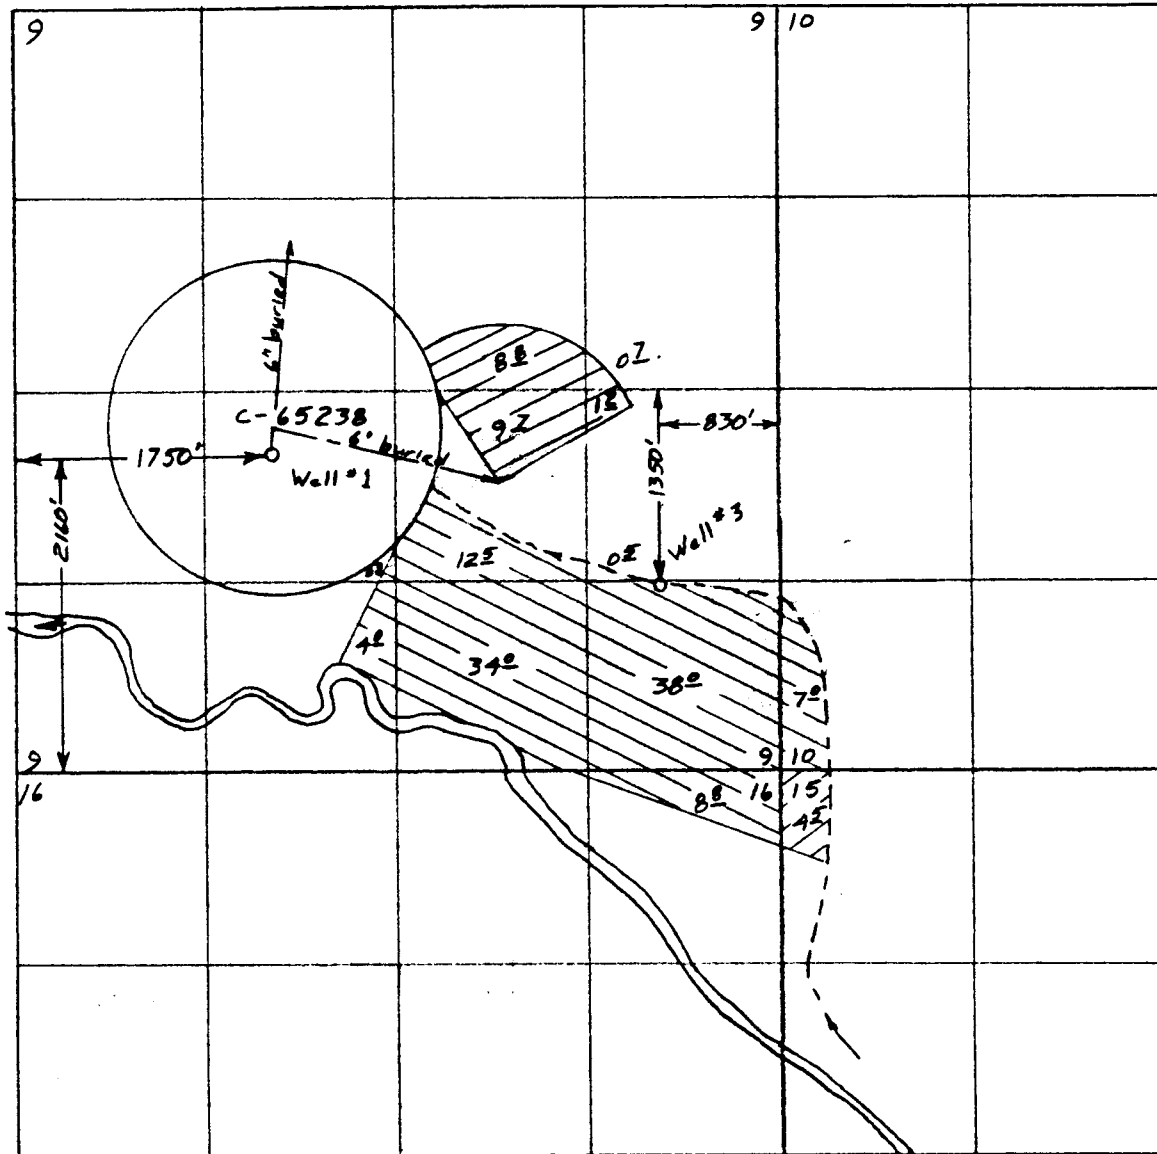

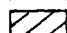



TOWNSHIP 17 SOUTH, RANGE 22 EAST, W.M.



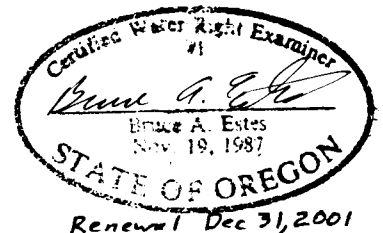
Scale 1" = 1320'

Surveyed Sep 23, 2000

-  Primary Irrigation from Well #1
-  Primary Irrigation from Well #3
-  Supplemental Irrigation from Well #3

Claim of Beneficial Use Map
for

TWIN BUTTES - SEVERANCE RANCH



App G-12826
Per G-12396

This map is for the purpose of locating a water right only and has no intent to provide legal dimensions or the location of property lines.

ESTES SURVEYS
 PO Box 17519 60382 Arnold Rd
 Salem, OR 97305-7519 Bend, OR 97702
 (503) 585-7593 (541) 382-7391