


# T. 4N., R. 27E., W. M.

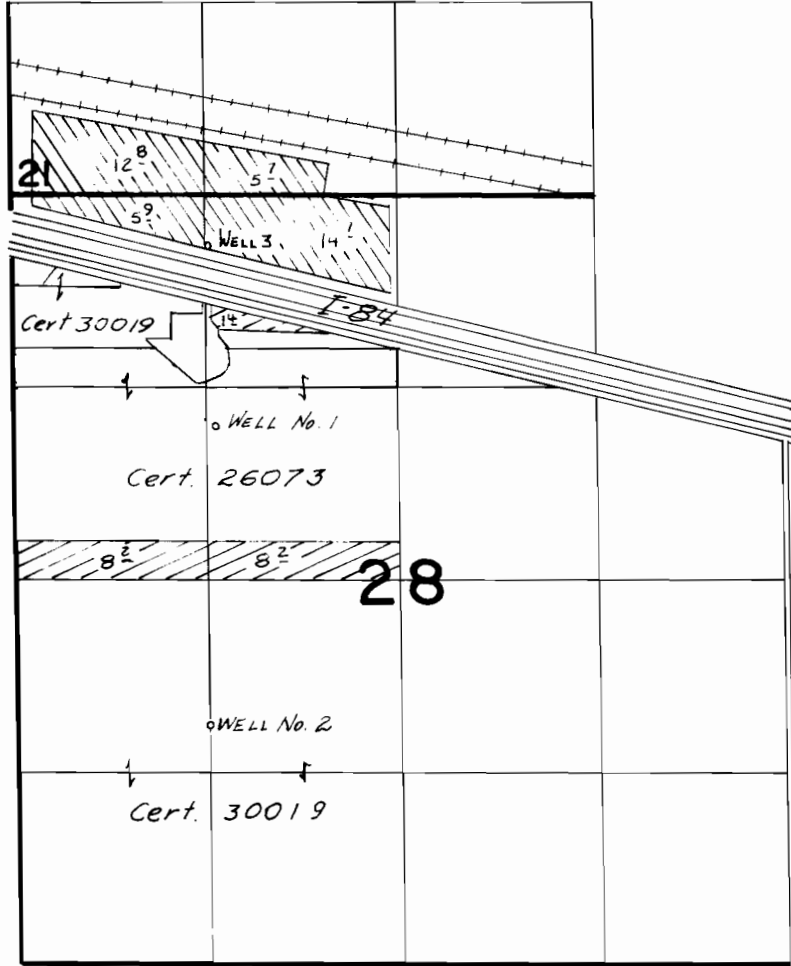

SCALE: 1" = 1320'

WELL No. 1 LOCATED 3700' N. & 1390' E. FROM SW COR. SECTION 28  
 WELL No. 2 LOCATED 1650' N. & 1320' E. FROM SW COR. SECTION 28  
 WELL No. 3 LOCATED 4940' N. & 1350' E. FROM SW COR. SECTION 28



WELL 1 & 2



WELL 3

## FINAL PROOF SURVEY UNDER

Application No. **G:5549** Permit No. **G:4929**  
 IN NAME OF

**J. W. AYLETT**

Surveyed 2-20 1981, by V. L. Church