


RECEIVED

MAY 17 1998

WATER RESOURCES DEPT.
SALIMA, OREGON

T. 8S., R. 46E., W.M.

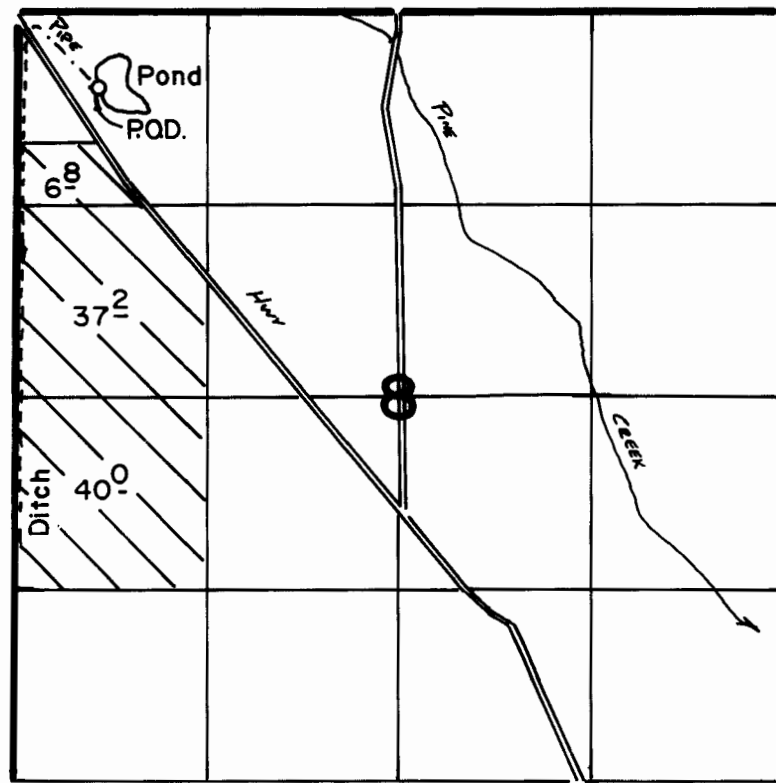

SCALE 1" = 1320'

P.O.D. Located 530'S. & 590'E From NW cor Sec 8

The purpose of this map is for identifying the location of the water right only and is not intended to provide legal dimensions of property ownership lines.

FINAL PROOF SURVEY

APPL. G-14153

PER. G-12826

IN NAME OF

GORDON W. SUMMERS

Surveyed Apr. 1, 1998

