



# FINAL PROOF SURVEY UNDER MIKAMI BROTHERS

Surveyed 3-3-93 by DGV

T. 5N.  
T. 4N.

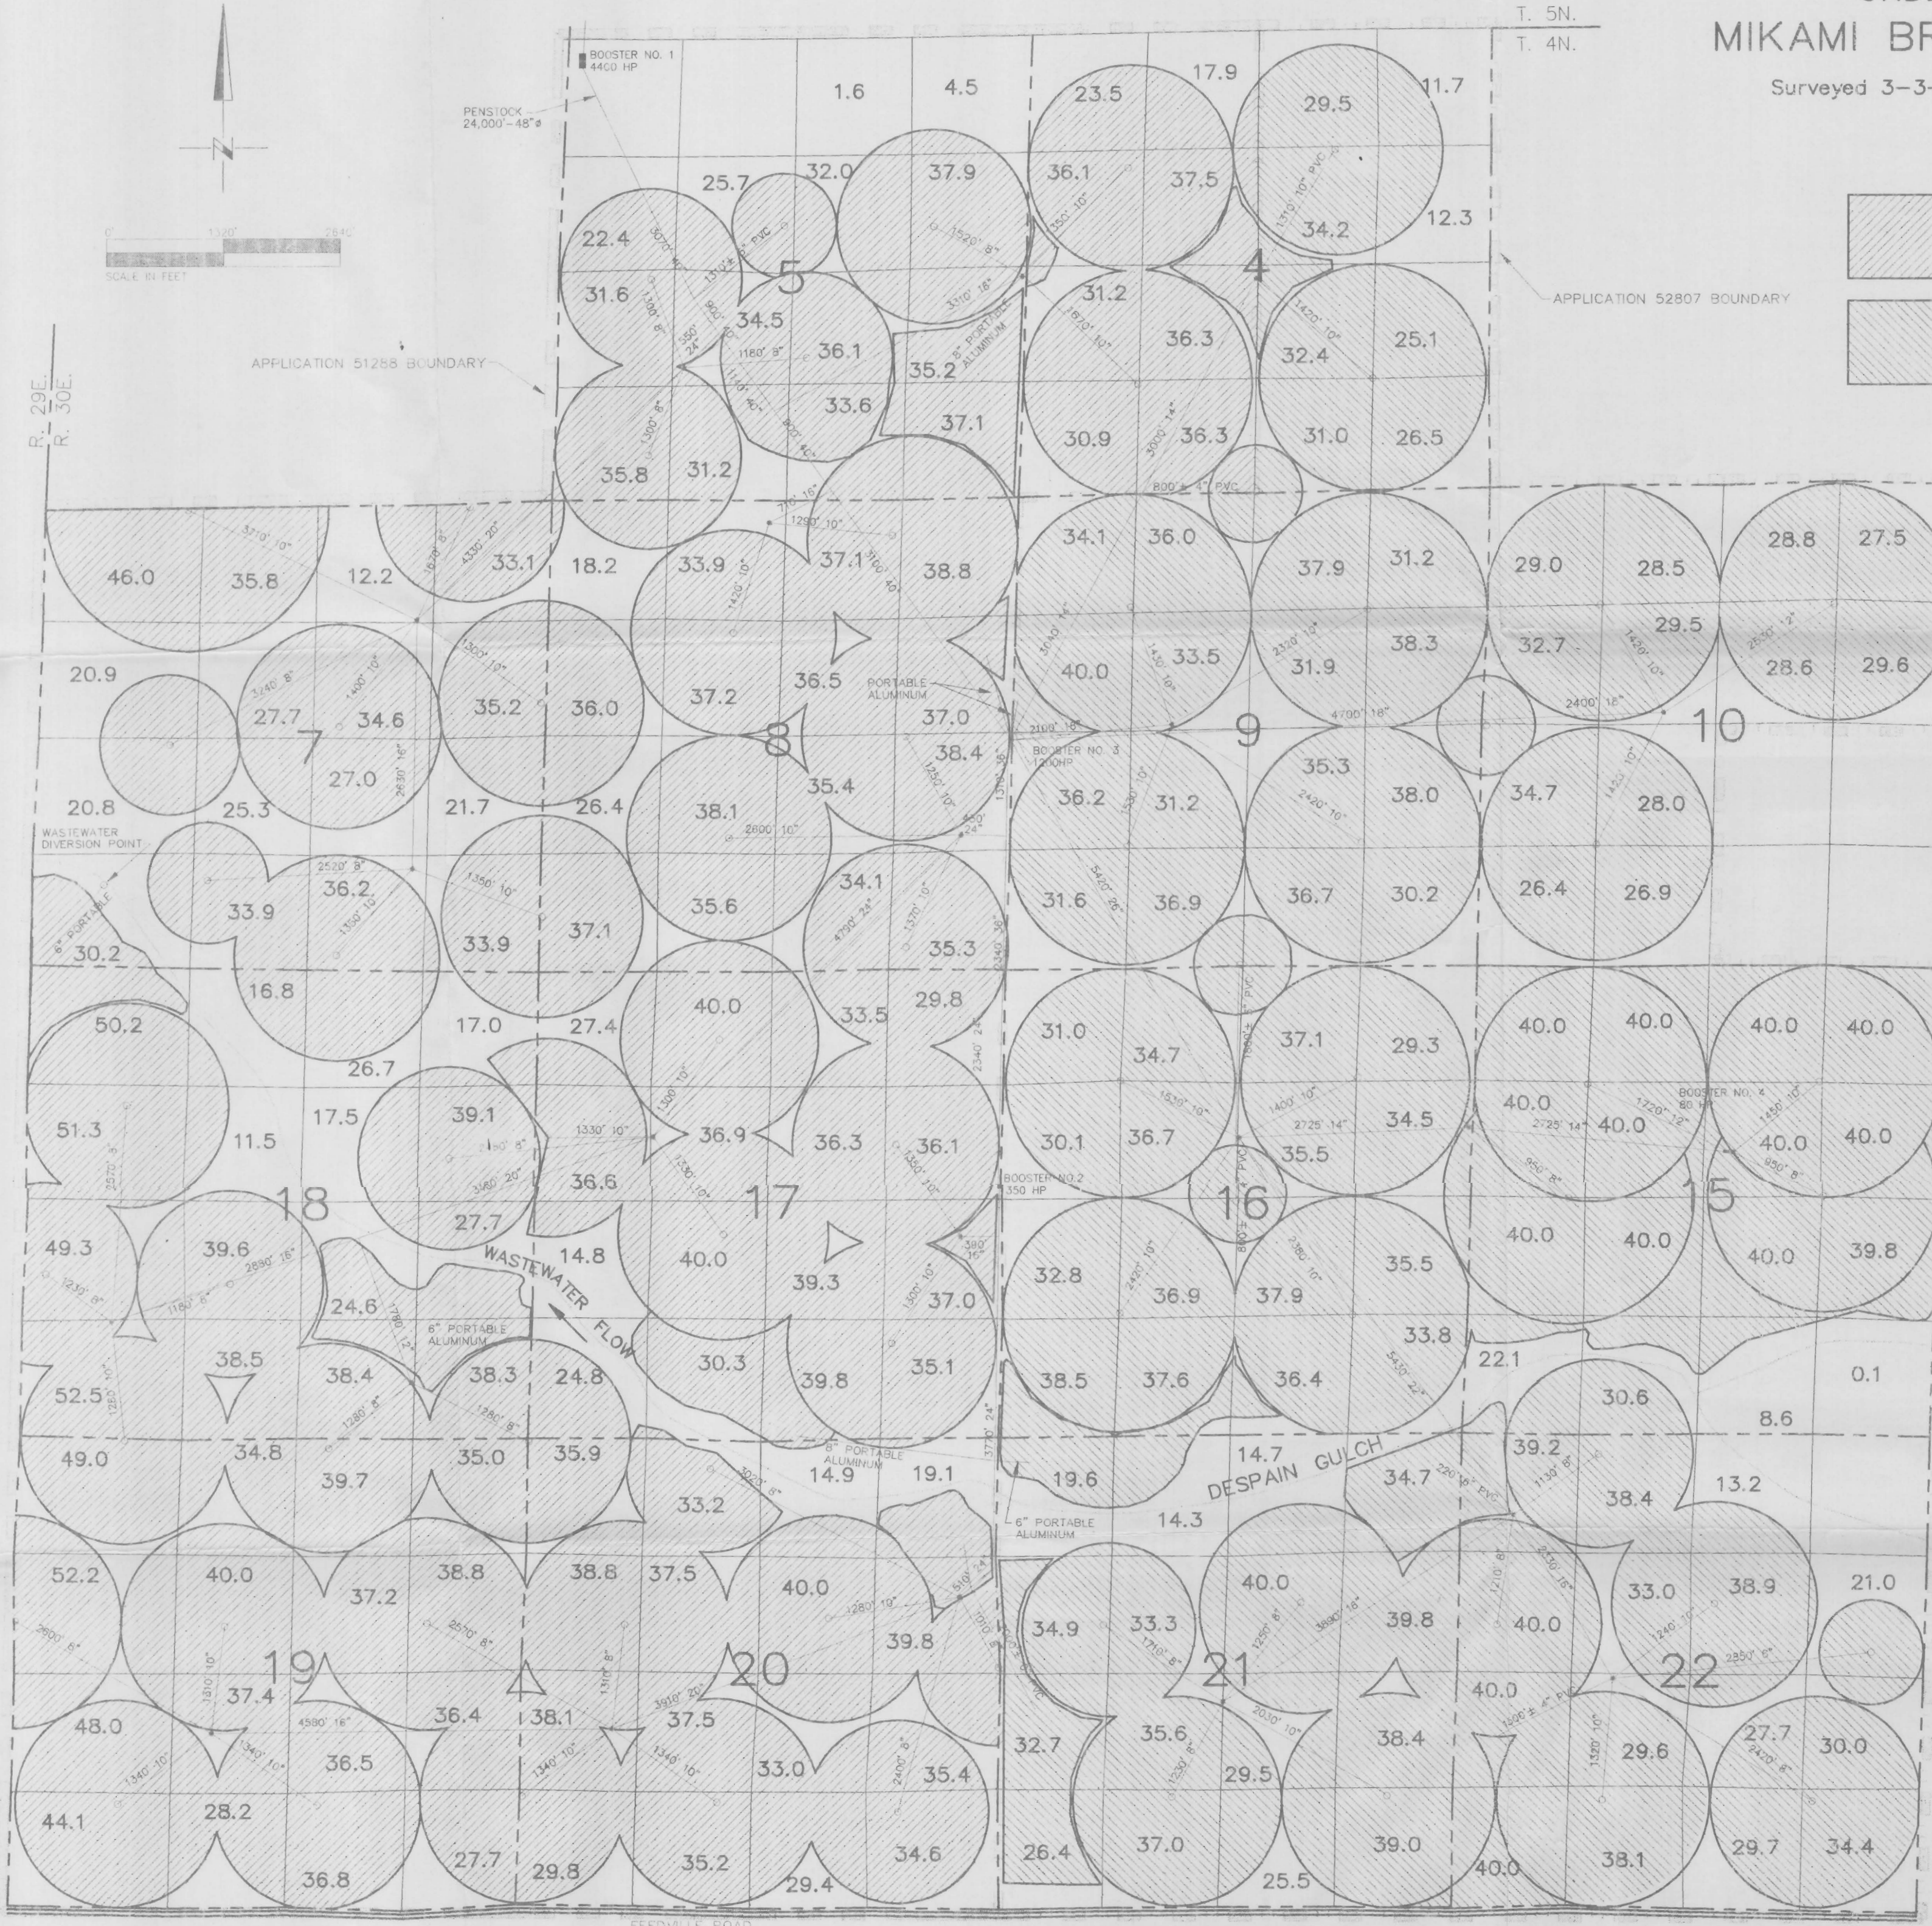

- APPLICATION 51288 PERMIT 37121 (4905.62 ACRES) ACTUAL IRRIGATED 3909.2 ACRES
- APPLICATION 52807 PERMIT 37833 (3200.00 ACRES) ACTUAL IRRIGATED 3200.0 ACRES

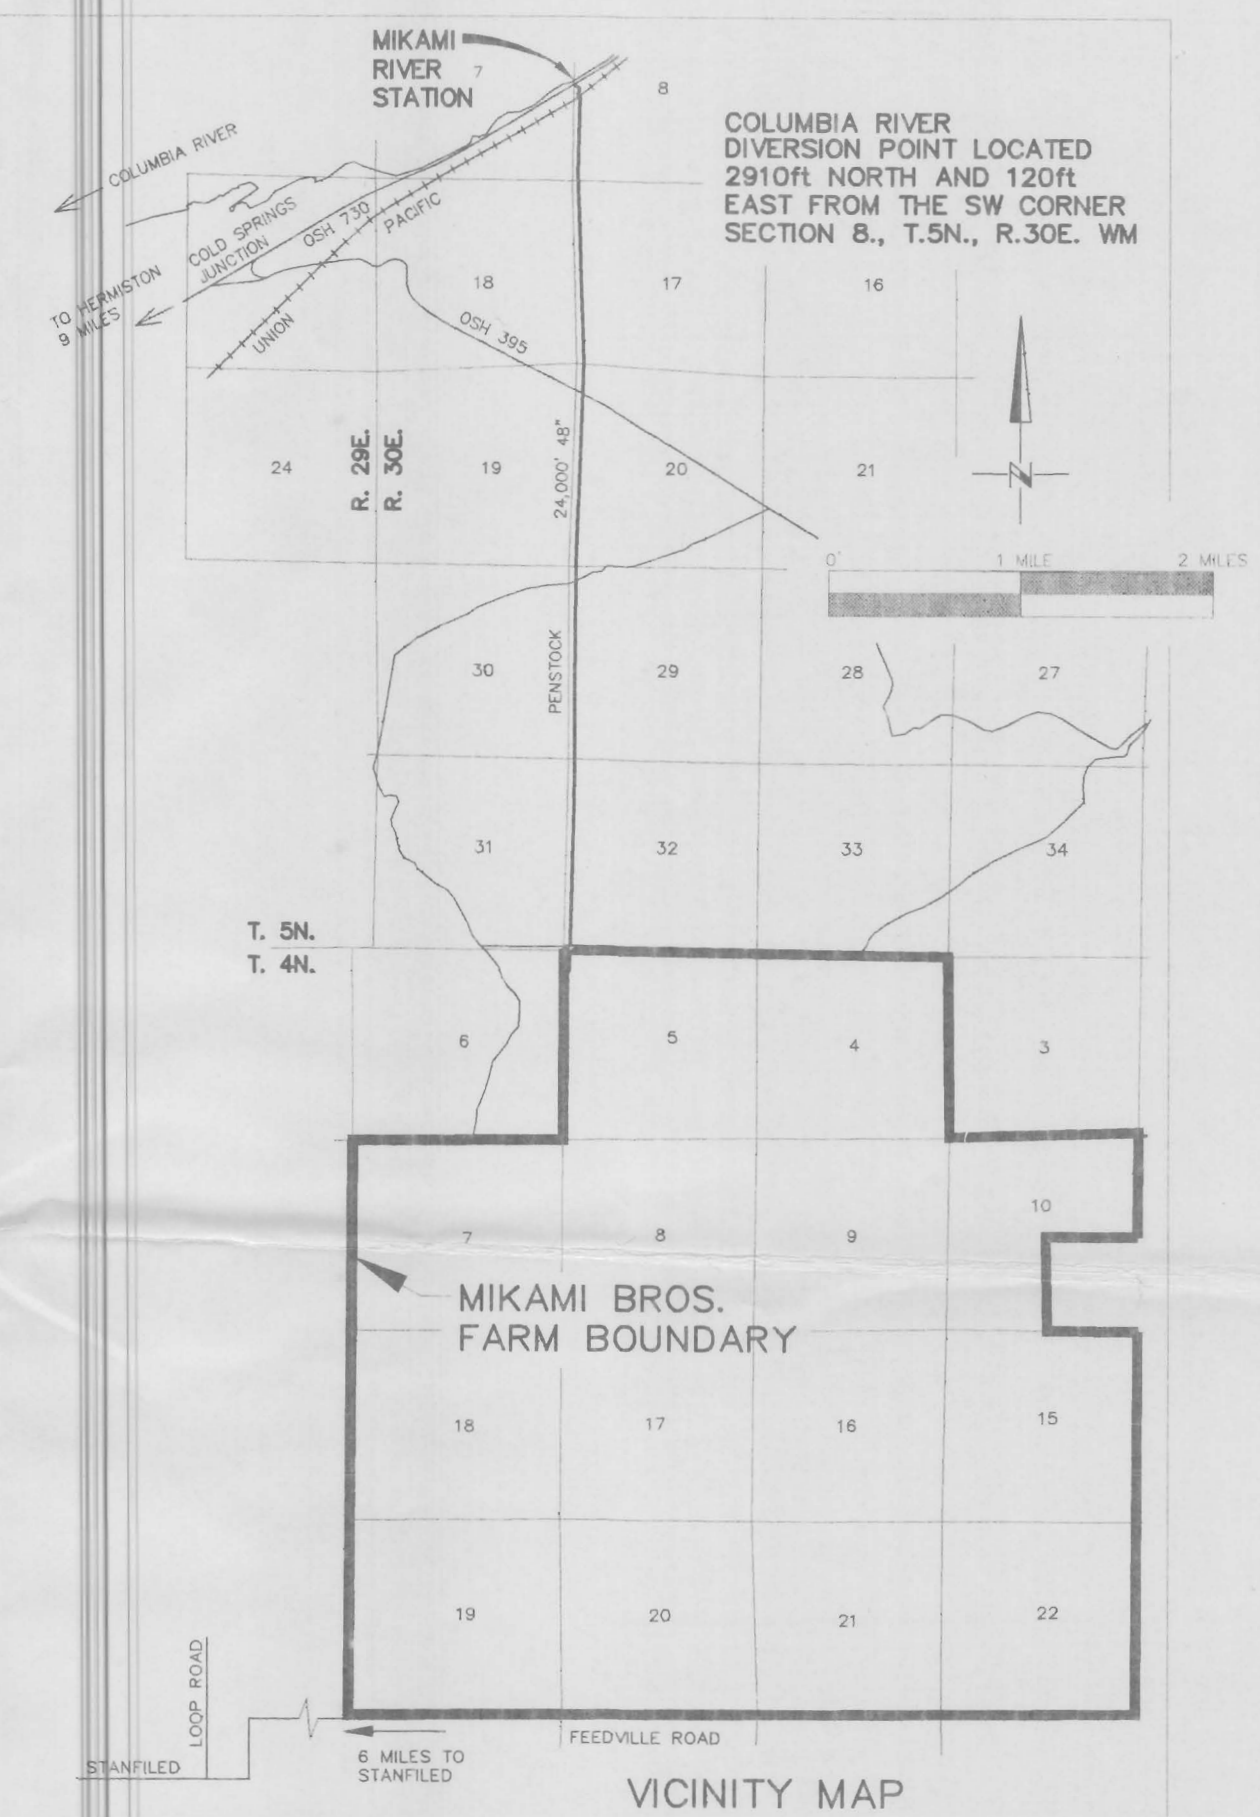

NOTE:  
THIS MAP IS FOR THE PURPOSE OF IDENTIFYING THE LOCATION OF THE WATER RIGHT ONLY AND IS NOT INTENDED TO PROVIDE LEGAL DIMENSIONS OR LOCATION OF PROPERTY OWNERSHIP LINES.  
INFORMATION ON THIS MAP HAS BEEN PREPARED USING EXISTING MAPS AND OTHER INFORMATION MADE AVAILABLE BY THE OWNERS AND INFORMATION OBTAINED IN THE FIELD WHERE AVAILABLE.

### IRRIGATED ACREAGE SUMMATION

APPLICATION 51288 PERMIT 37121 TOTAL IRRIGATED ACREAGE 3909.2				APPLICATION 52807 PERMIT 37833 TOTAL IRRIGATED ACREAGE 3200.0			
SECTION	TRACT	ACRES	TRACT	TRACT	ACRES	TRACT	TRACT
4	NE 1/4 NW 1/4	17.9	NE 1/4 NW 1/4	17.0	4	NE 1/4 NE 1/4	11.7
	NW 1/4 NW 1/4	23.5	NW 1/4 NW 1/4	12.2		NW 1/4 NE 1/4	29.5
	SW 1/4 NW 1/4	36.1	SW 1/4 NW 1/4	17.5		SW 1/4 NE 1/4	34.2
	SE 1/4 NW 1/4	37.5	SE 1/4 NW 1/4	19.1		SE 1/4 NE 1/4	12.3
	TOTAL SEC 4 - 249.7		TOTAL SEC 7 - 474.5			TOTAL SEC 4 - 202.7	
5	NE 1/4 NE 1/4	4.5	NE 1/4 NE 1/4	35.0	15	NE 1/4 NE 1/4	40.0
	NW 1/4 NE 1/4	1.5	NW 1/4 NE 1/4	37.1		NW 1/4 NE 1/4	40.0
	SW 1/4 NE 1/4	32.0	SW 1/4 NE 1/4	36.2		SW 1/4 NE 1/4	40.0
	SE 1/4 NE 1/4	37.7	SE 1/4 NE 1/4	39.6		SE 1/4 NE 1/4	40.0
	TOTAL SEC 5 - 399.2		TOTAL SEC 8 - 555.1			TOTAL SEC 15 - 541.2	
17	NE 1/4 NE 1/4	29.8	NE 1/4 NE 1/4	19.1	10	NE 1/4 NE 1/4	27.5
	NW 1/4 NE 1/4	33.5	NW 1/4 NE 1/4	14.9		NW 1/4 NE 1/4	28.6
	SW 1/4 NE 1/4	36.3	SW 1/4 NE 1/4	38.8		SW 1/4 NE 1/4	29.6
	SE 1/4 NE 1/4	36.1	SE 1/4 NE 1/4	37.5		SE 1/4 NE 1/4	29.6
	TOTAL SEC 17 - 537.7		TOTAL SEC 20 - 532.2			TOTAL SEC 10 - 350.2	

MIKAMI BROS. FARM  
T. 4N., R. 30E., W.M.

**SCM** Consultants, Inc.  
Architects & Engineers, Kennewick, WA

2347.010  
FILE: 2437WR-R.DWG  
12/4/98