


T8S, R40E, Sections 9 and 10, W.M.

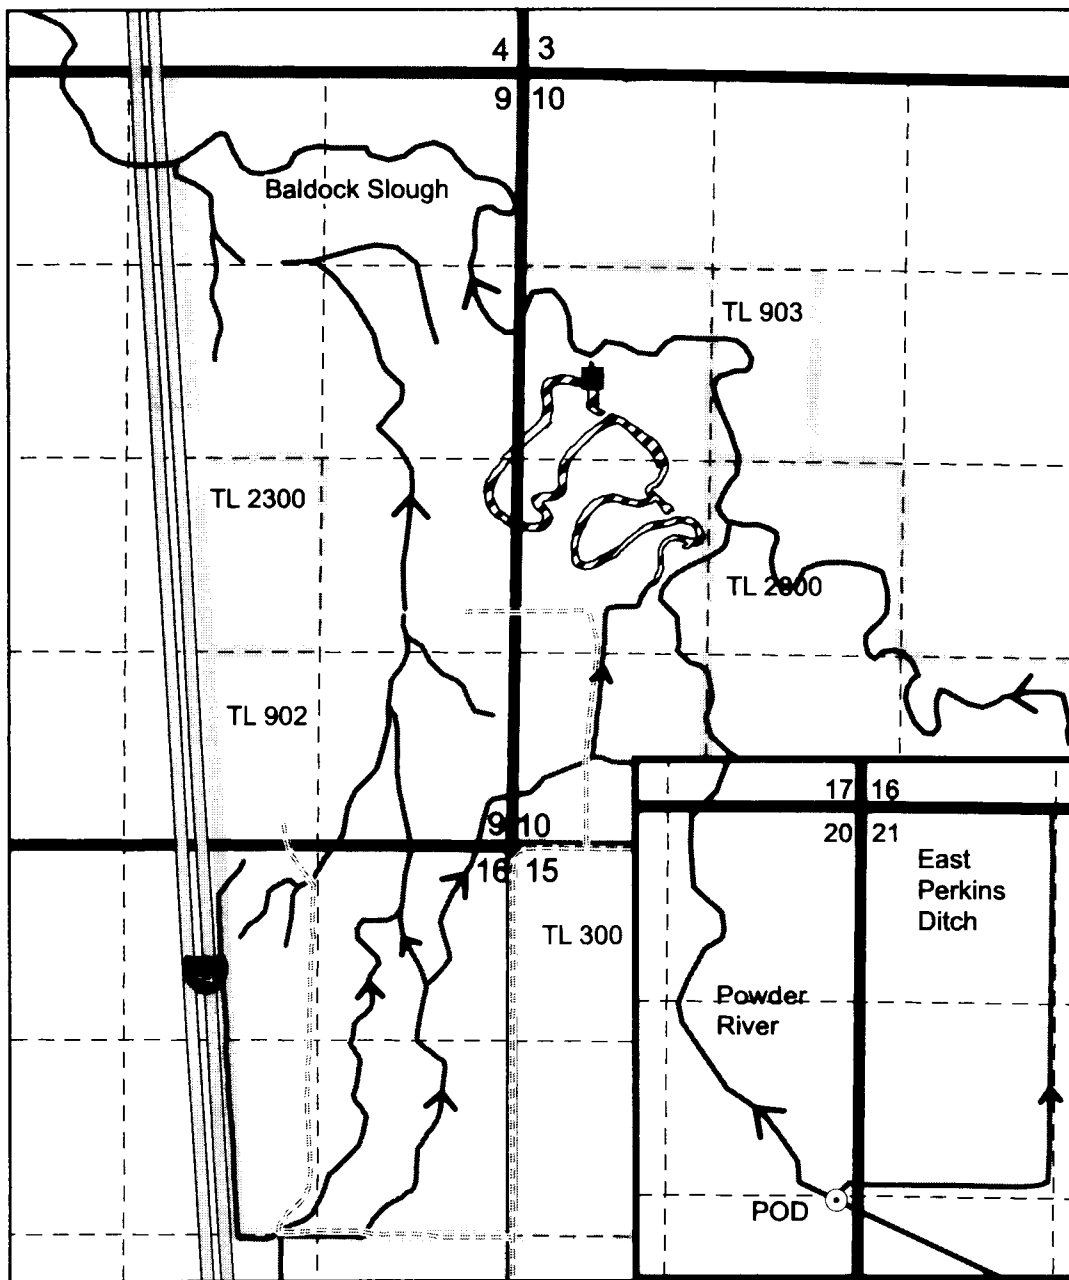


The dam (weir) for pond C is located 470 feet east and 2,095 feet south of the NW corner of Section 10, T8S, R40E.

The Perkins Ditch POD on the Powder River is located 2660 feet south and 140 feet west of the NE corner of Section 20, T8S, R40E.

This map is not intended to provide legal dimensions or locations of property ownership lines

- Pond C
- POD
- Weir and measuring point
- Tax lot line
- Quarter quarter line
- Section line
- River
- Paved road
- Dirt road
- Freeway
- Ditch / Constructed waterway

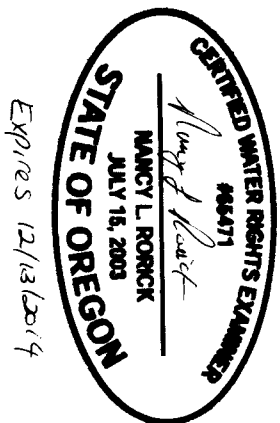

Claim of Beneficial Use, Pond C
 Permit R13081 and Application R84545
 Tax Lot 902
 Baldock Slough, LLC
 map prepared by
 Nancy Rorick Consulting