



MAP PREPARED FOR:  
CASCADIAN NURSERIES  
8900 NW DICK RD.  
HILLSBORO, OR 97124

C 1/4  
CORNER

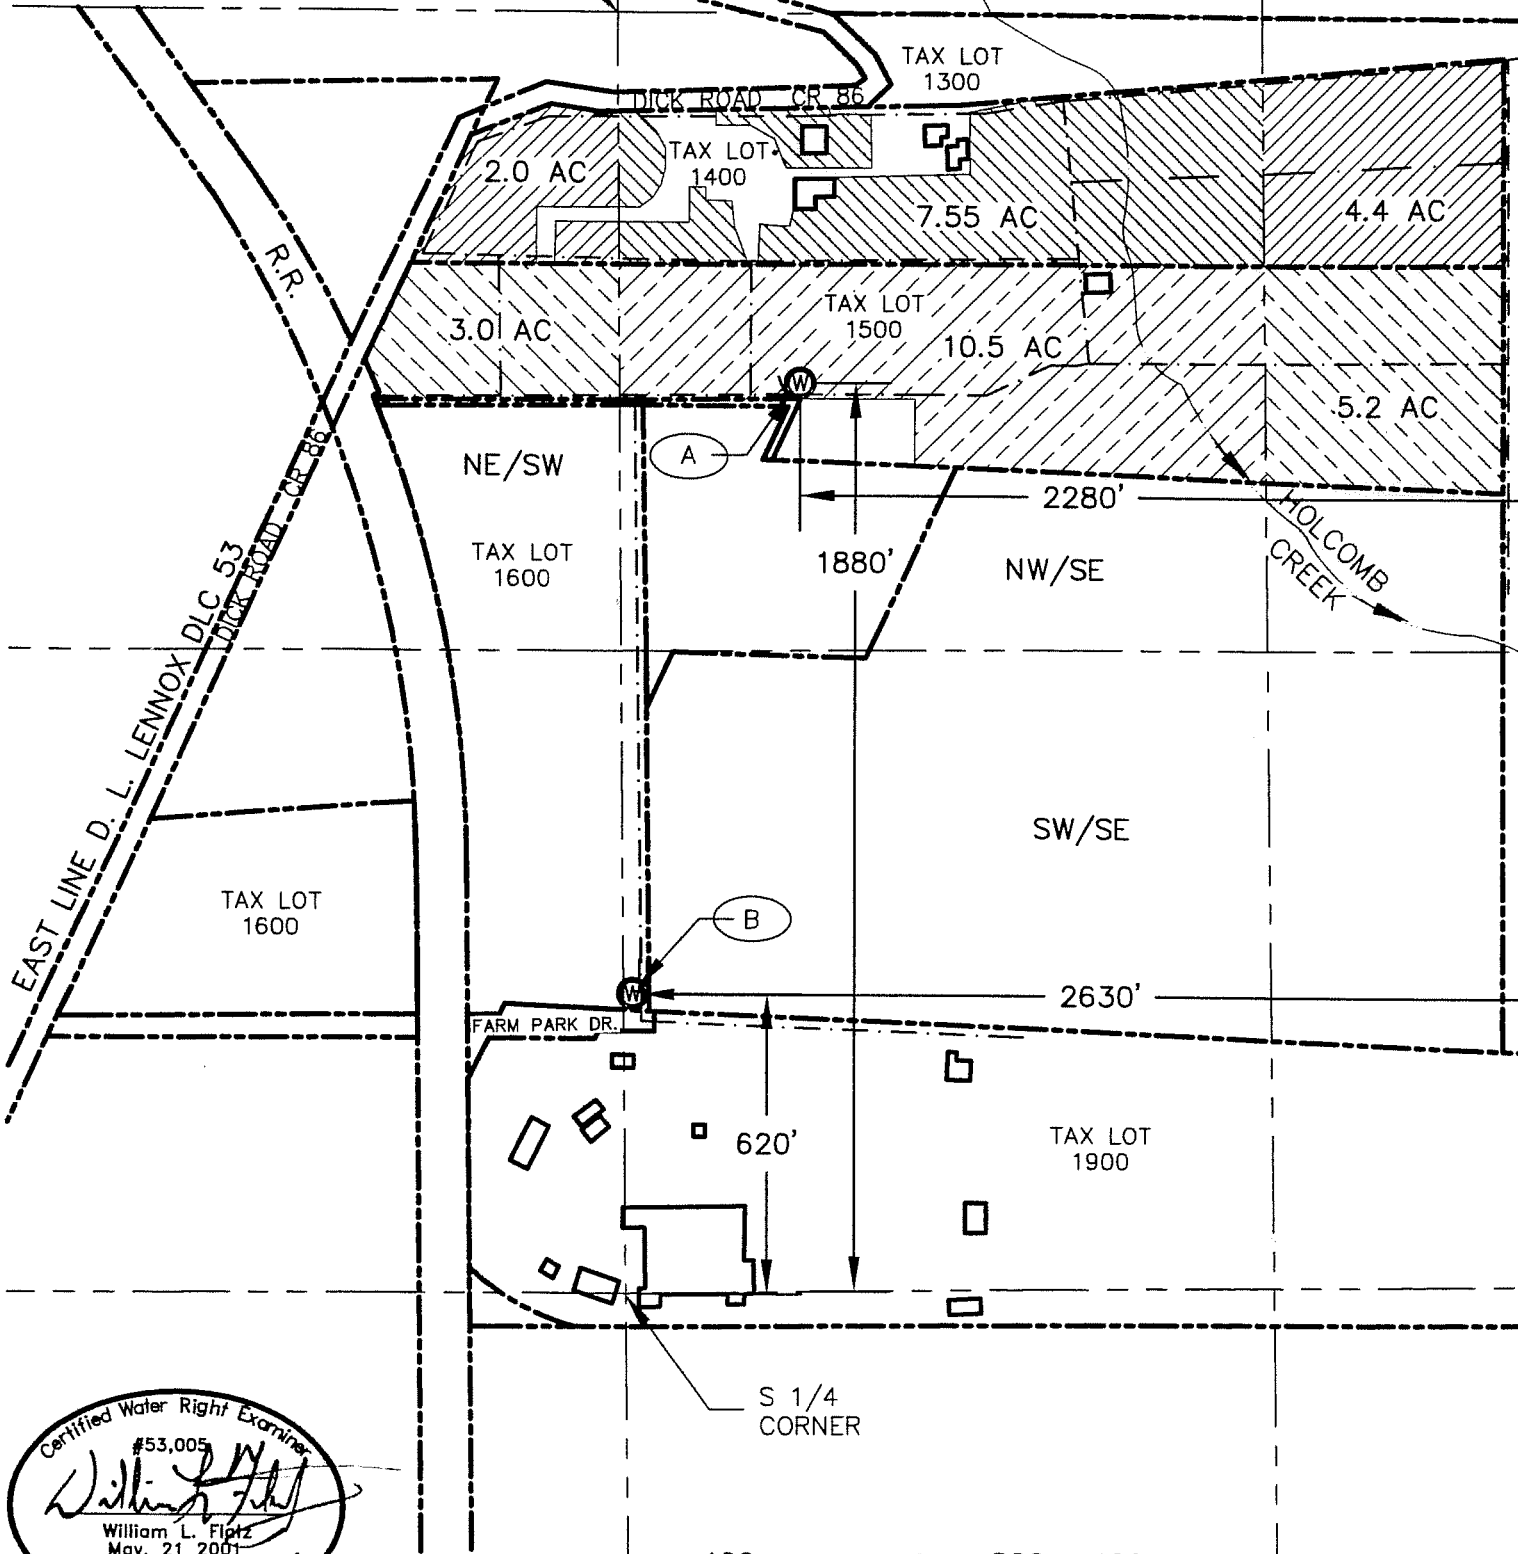

832

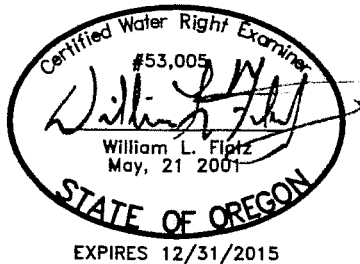

1 inch = 400 ft.

PREPARATION O  
PURPOSE OF IDEN  
THE WATER RIGHT  
TO PROVIDE DIME  
PROPERTY

SOURCE OF MAP DATA:  
ASSESSORS MAP, GOOGLE AIR PHOTO 2012