

**RECEIVED**

AUG 9 1999

WATER RIGHTS DEPT.  
SALEM, OREGON

**FINAL  
PROOF  
SURVEY  
RESERVOIR**

DLC 39

POINT OF DIVERSION  
UNDER T-7263

DLC 40

DITCH SUPPLIES WATER TO  
SUMP UNDER T-7263 DURING  
IRRIGATION SEASON ONLY

CARIS CREEK

**RESERVOIR**

(ALSO SUMP UNDER T-7263)

INLET: 366' NORTH & 56' EAST  
OUTLET: 300' NORTH & 52' EAST  
FROM SW COR. SECTION 30

25 30  
36 31

DLC 38

T.37 S.

R.5 W.

R.4 W. W.M.

**APPLICATION R-75053 PERMIT R-12659  
IN NAME OF**


**CHERYL SHAW**

**SURVEYED: JULY 16, 1999**

BY:

JONATHAN C. SPERO C.W.R.E. 123  
1002 KINCAID RD./P.O. BOX 16  
WILLIAMS, OREGON 97544  
PH. (541) 846-6845

THIS MAP IS FOR THE PURPOSE OF  
IDENTIFYING THE LOCATION OF THE  
WATER RIGHT ONLY AND IS NOT IN-  
TENDED TO PROVIDE LEGAL DIMEN-  
SIONS OR LOCATIONS OF PROPERTY  
OWNERSHIP LINES.

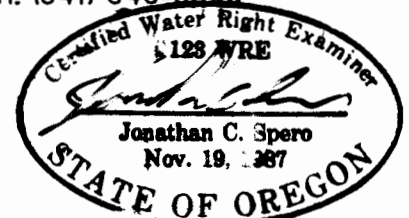

**SCALE: 1" = 400'**

RENEWAL DATE: JUNE 30, 2000