


RECEIVED

SEP 16 1999

WATER RESOURCES DEPT.
SALEM, OREGON

T.4S. R.2 & 3W., W.M

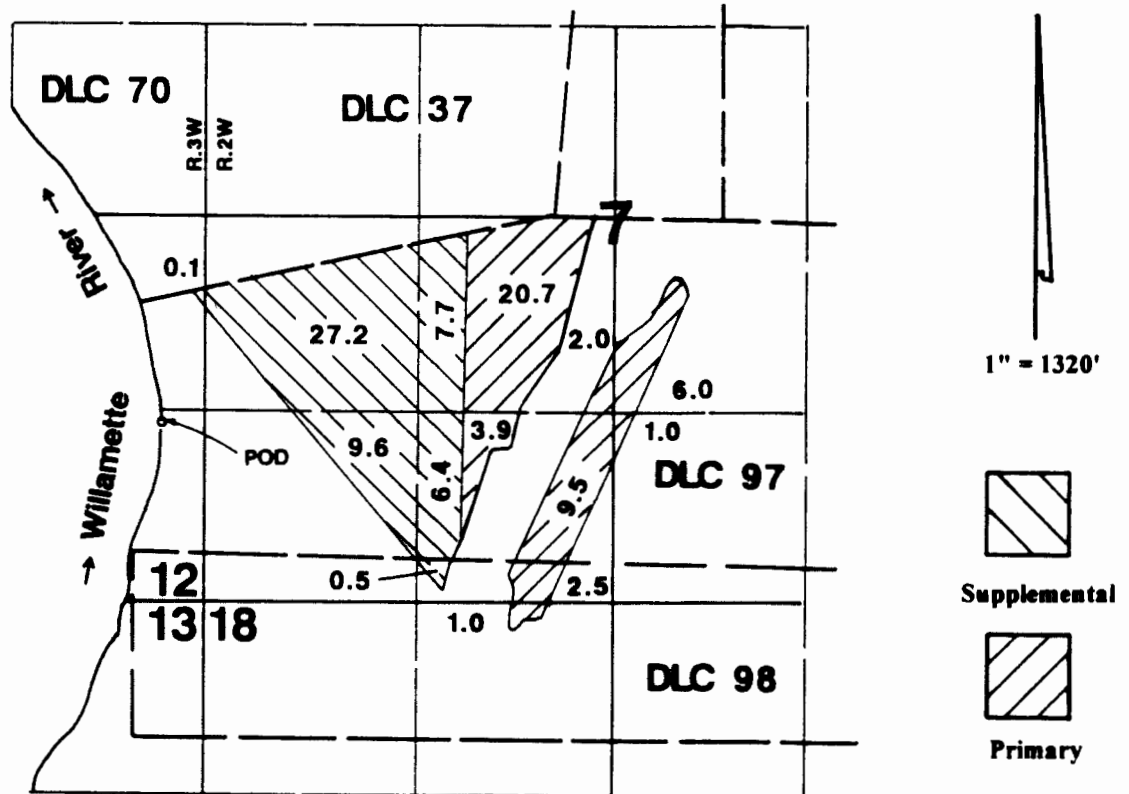

POD is located 370'S & 2700'W from the SE corner of DLC 37.

Final Proof Survey

Application #: S-75206 Permit #: 51958

In Name Of

Mission Lane Farms

Surveyed on September 3, 1999 by JM Schuette

This Map Was Prepared For The Purpose Of Identifying The Location Of A Water Right Only And Is Not Intended To Provide Legal Dimensions Or Location Of Property Ownership Lines.

