
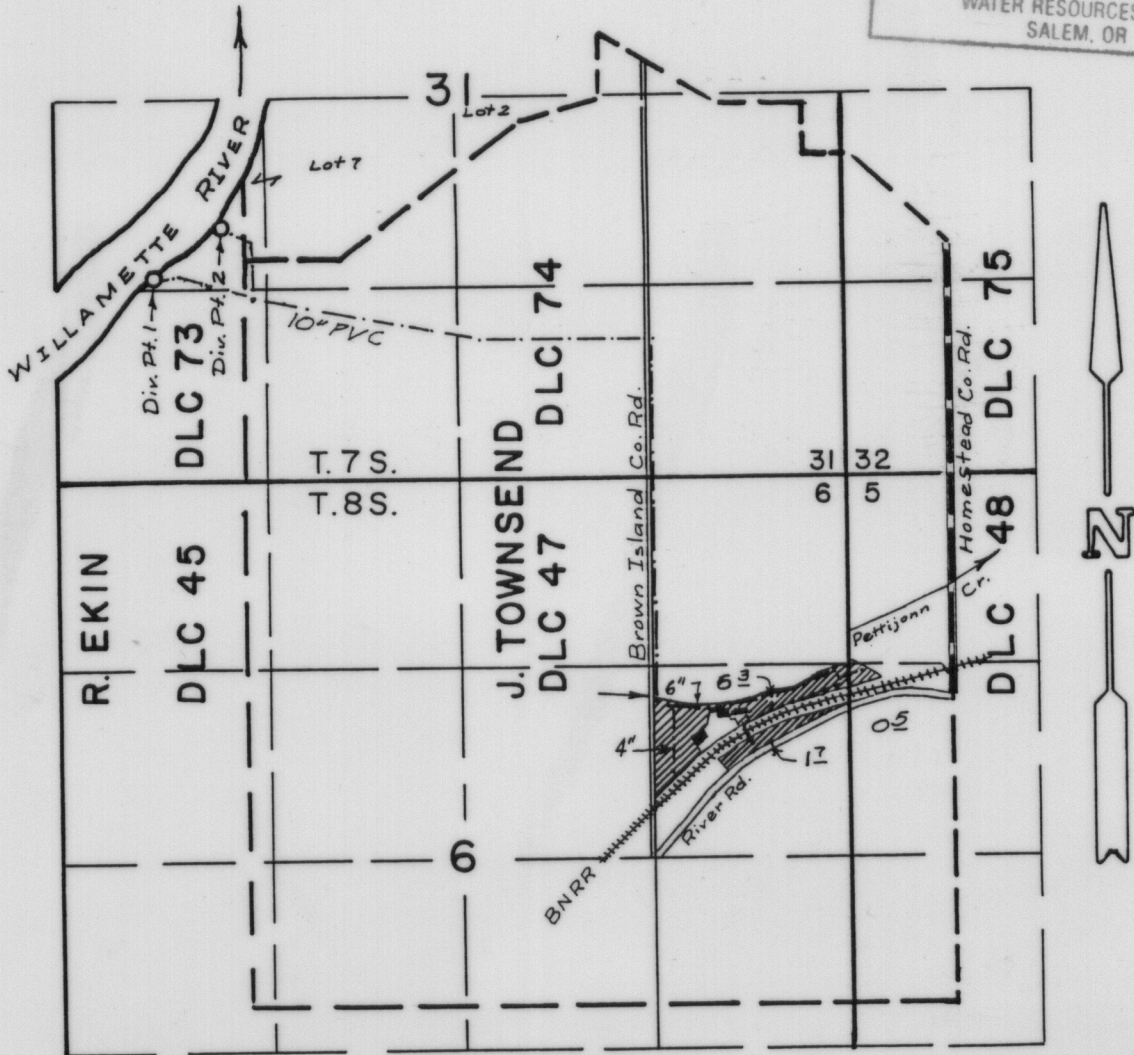


T. 7 & 8 S. R. 3 W. W. M.

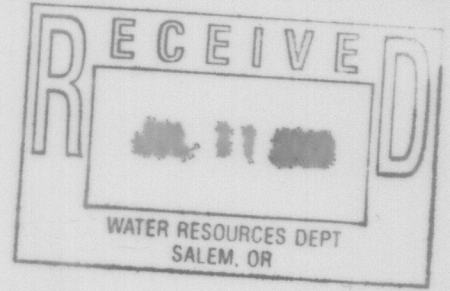

Scale 1" = 1320'

Div. Pt. 1 located 1440' N. & 660' E. from S.W. Cor. Sec. 31

Div. Pt. 2 located 200' N. & 150' W. from NW Cor. Townsend DLC 74


**FINAL PROOF SURVEY**  
UNDER

Application No. 72635 Permit No. 51986

IN NAME OF

**WALTER R. MILLER**

Surveyed June 26, 2000, by .....

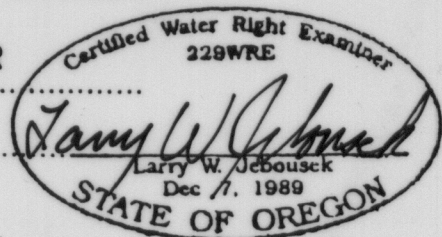

THIS MAP WAS PREPARED FOR THE PURPOSE OF IDENTIFYING THE LOCATION OF A WATER RIGHT ONLY AND IS NOT INTENDED TO PROVIDE LEGAL DIMENSIONS OR LOCATION OF PROPERTY OWNERSHIP LINES.