

CLAIM OF BENEFICIAL USE MAP

SCALE: 1 INCH = 400 FEET

DLC 39

POINT OF DIVERSION T-7263

PREPARED BY:
JONATHAN C. SPERO C.W.R.E. 123
1002 KINCAID RD./P.O. BOX 16
WILLIAMS, OREGON 97544
PH. (541) 846-6845

IRRIGATION & SUPPLEMENTAL IRRIGATION FROM 2 WELLS

PARCEL 1 OF PARTITION PLAT JOSEPHINE COUNTY, OREGON.

PARCEL 2 OF PARTITION PLAT JOSEPHINE COUNTY, OREGON.

DLC 40

WELL # 1
500 FEET NORTH & 10 FEET WEST FROM NE CORNER SEC. 36

BURIED 12" PIPE

SUMP / RESERVOIR

THE INTENT OF THIS REVISED CLAIM OF BENEFICIAL USE IS THAT IRRIGATION AND SUPPLEMENTAL IRRIGATION FROM WELL # 1 SHOWN HEREON IS FOR THE BENEFIT OF PARCEL 2 OF PARTITION PLAT NO.

AND THAT IRRIGATION AND SUPPLEMENTAL IRRIGATION FROM WELL # 2 SHOWN HEREON IS FOR THE BENEFIT OF PARCEL 1 OF SAID PARTITION PLAT.

BURIED 1" PIPE

WELL # 2
270 FEET SOUTH & 340 FEET WEST FROM NE CORNER SECTION 36

T.37 S.

R.5 W. R.4 W.
W.M.



PRIMARY IRRIGATION UNDER THIS PERMIT (G-12784)




SUPPLEMENTAL IRRIGATION TO T-7263

DLC 38

UNDER:
APPLICATION G-13891 PERMIT G-12784
IN NAME OF: CHERYL L. SHAW

SURVEYED JULY 16, 1999
THIS REVISED CLAIM MAP
PREPARED MARCH 3, 2003

THIS MAP IS FOR THE PURPOSE OF IDENTIFYING THE LOCATION OF THE WATER RIGHT ONLY, AND IS NOT INTENDED TO PROVIDE LEGAL DIMENSIONS OR LOCATIONS OF PROPERTY OWNERSHIP LINES.

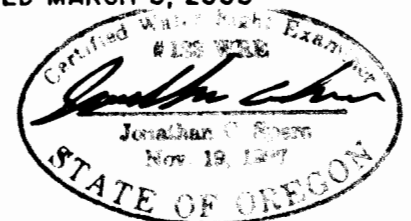

LICENSE RENEWAL DATE:
JUNE 30, 2004