

**T. 17 S. R. 3 W. W. M.
SECTION 14**

10 11 LANE COUNTY, OREGON 11 12

15 14 14 13

LW 1/4

NE 1/4

4" MAIN
LINE

LIE COR. WM. STEVENS
S.D.L.C. NO. 46

MCKENZIE RIVER
DIV. ST. 2

SE 1/4

DEADMOLD


15 14 14 13

22 23 23 24

WM. STEVENS
DLC NO. 46

PRIORITY DATE
MARCH 16, 1995

SCALE
1" = 1320'

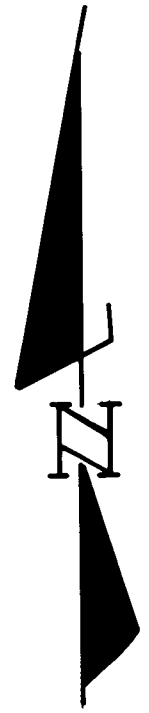

POINT OF DIVERSION
940.0 NORTH AND 1815.0
EAST OF THE LIE COR. WM.
STEVENS DLC NO. 46

THIS MAP IS FOR WATER RIGHT
PURPOSES ONLY AND DOES NOT
PROVIDE DATA TO LOCATE
PROPERTY BOUNDARIES

**FINAL PROOF SURVEY
UNDER**

APPLICATION NO. S-80124 PERMIT NO. 52746

IN NAME OF


**LARRY RAY BRABHAM
&**

BARBARA COCHRANE

SURVEYED JANUARY 19, 1995 BY CHARLES W. GUILÉ
FIELD INSPECTION JUNE 29, 2000 " " "

SOURCE: WILLAMETTE
BASIN PROJECT RES-
VOIR, TRIBUTARY TO
THE MCKENZIE
RIVER.

RECEIVED

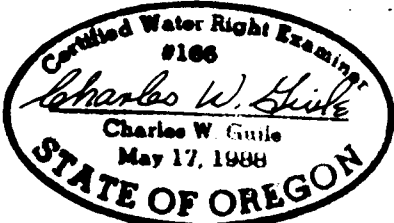

**CHARLES W. GUILÉ
& ASSOCIATES, CO.**
Land Surveying
52 Centennial Loop
Eugene, OR 97401

AUG 17 2000

6/30/2001

95-02