


RECEIVED

SEP 21 1999

WATER RESOURCES DEPT.  
SALEM, OREGON

# T.5S. R.1E., W.M

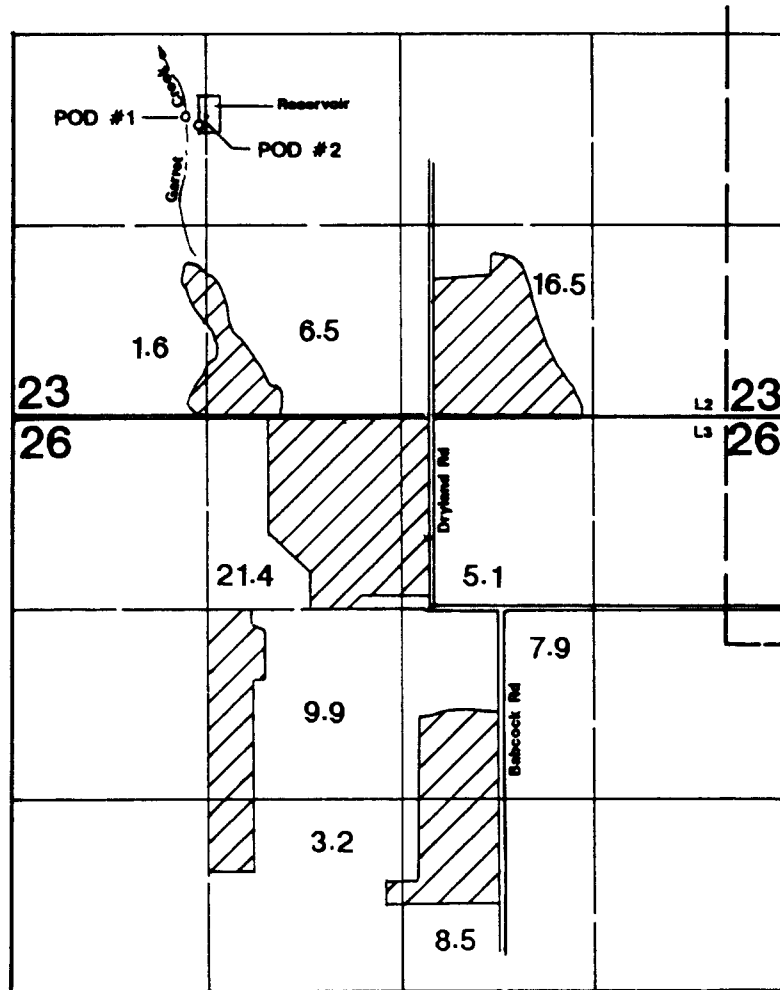

POD #1 is located 2005'N & 1180'E from the SW corner of Section 23.  
POD #2 is located 1970'N & 1280'E from the SW corner of Section 23.

## Final Proof Survey

Application #: R-71342 Permit #: R-11593  
S-71343 51816

In Name Of

### Elton D. Kemnitz

Surveyed on September 7, 1999 by JM Schuette

This Map Was Prepared For The Purpose Of Identifying The  
Location Of A Water Right Only And Is Not Intended To Provide  
Legal Dimensions Or Location Of Property Ownership Lines.

