



CLAIM OF BENEFICIAL USE
 SURVEY SEPTEMBER 25, 2001
 BY DUANE W. KIRBY
 FOR LEE WALKER
 APPLICATION NO. S-81256
 PERMIT NO. 53216
 T28S, R7W, W.M.
 SECTION 31

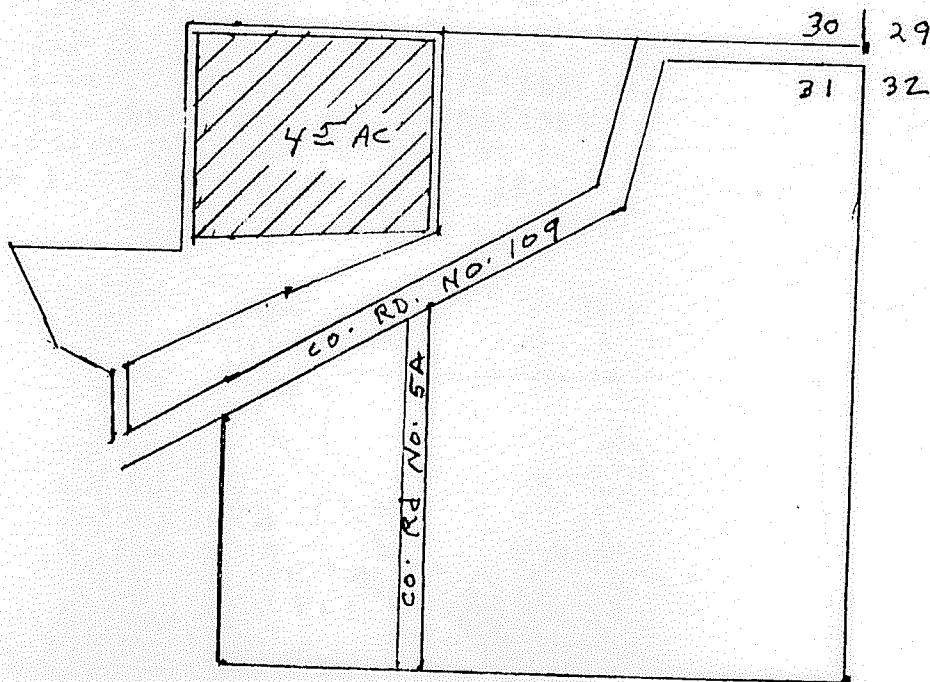

SCALE : 1" = 400'

T29S, R7W, W.M., SECTION 3

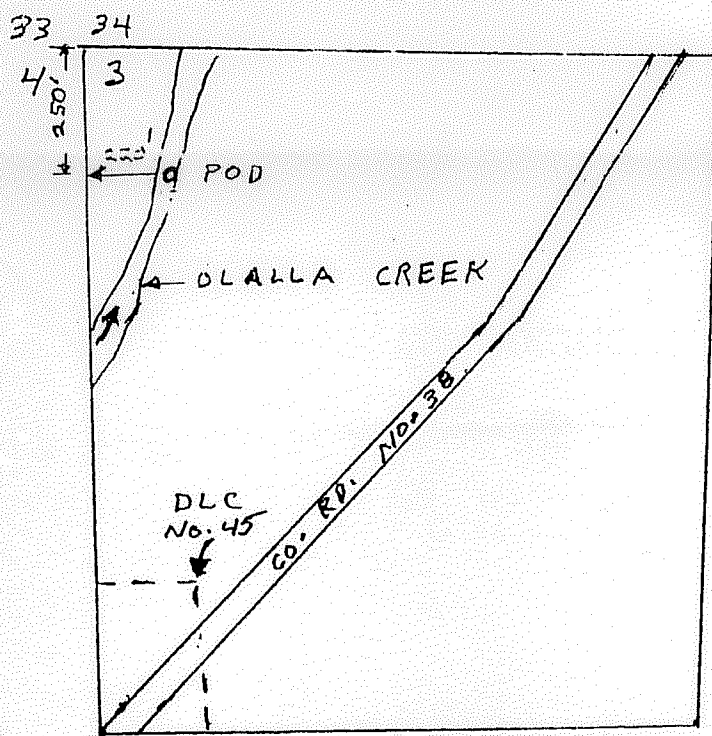

RECEIVED

OCT 03 2001

WATER RESOURCES DEPT.
 SALEM, OREGON

THE PURPOSE OF THIS MAP IS TO
 IDENTIFY THE LOCATION OF THE
 WATER RIGHT. IT IS NOT INTENDED
 TO PROVIDE INFORMATION RELATIVE
 TO THE LOCATION OF PROPERTY
 OWNERSHIP BOUNDARY LINES.

