


RECEIVED

SEP 21 1999

WATER RESOURCES DEPT
SALEMA, OREGON

TOWNSHIP 15 SOUTH, RANGE 5 WEST, W.M.

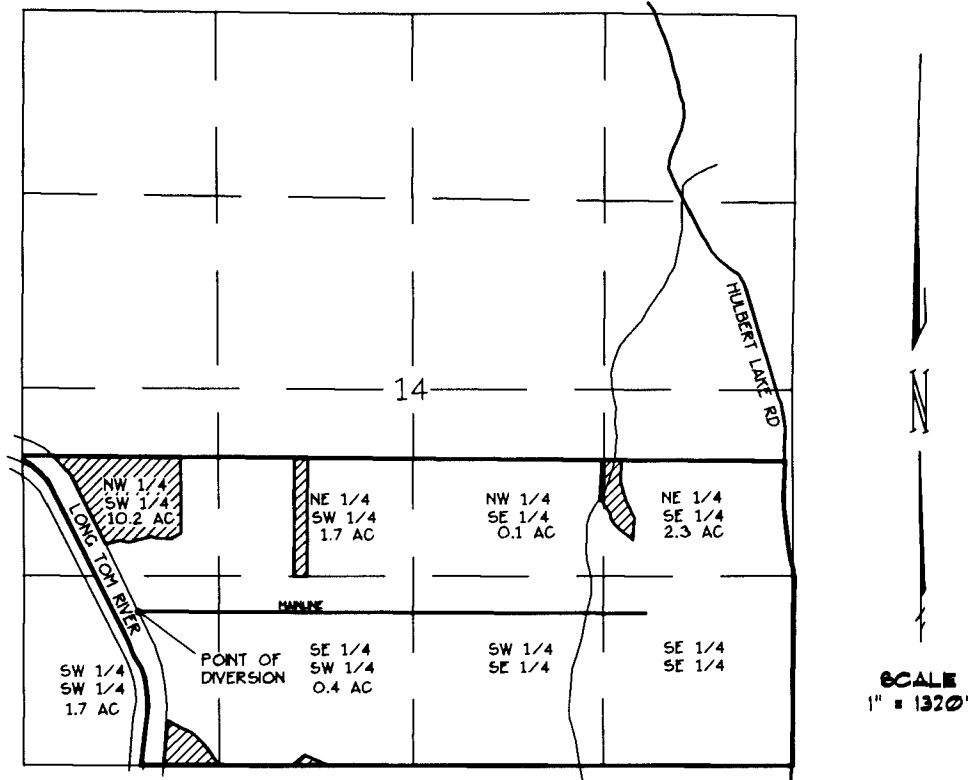


DIVERSION POINT LOCATION

1040.0 FEET NORTH + 755.0 FEET
EAST OF THE SOUTHWEST CORNER
OF SECTION 14.



DENOTES AREA
OF BENEFICIAL USE

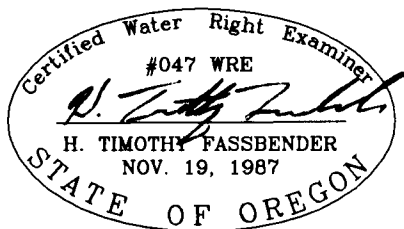

NOTE:

THIS MAP WAS PREPARED FOR THE
PURPOSE OF IDENTIFYING THE
LOCATION OF THE WATER RIGHT ONLY.
IT IS NOT INTENDED TO PROVIDE
DIMENSIONS OR LOCATION OF
PROPERTY OWNERSHIP LINES.

FINAL PROOF SURVEY

FOR
APPLICATION 8-74405, PERMIT 52032
REERLEY PROPERTIES
220 EAST 18TH STREET
JUNCTION CITY, OREGON 97448
541-998-1510

BY
FORD-NEBB-FASSBENDER, INC.
PO BOX 22735
EUGENE, OR 97402
541-344-1852

JOB NO. 3587
DWG NO. JC3587.DWG