



T.33S.,R.1W.,W.M.

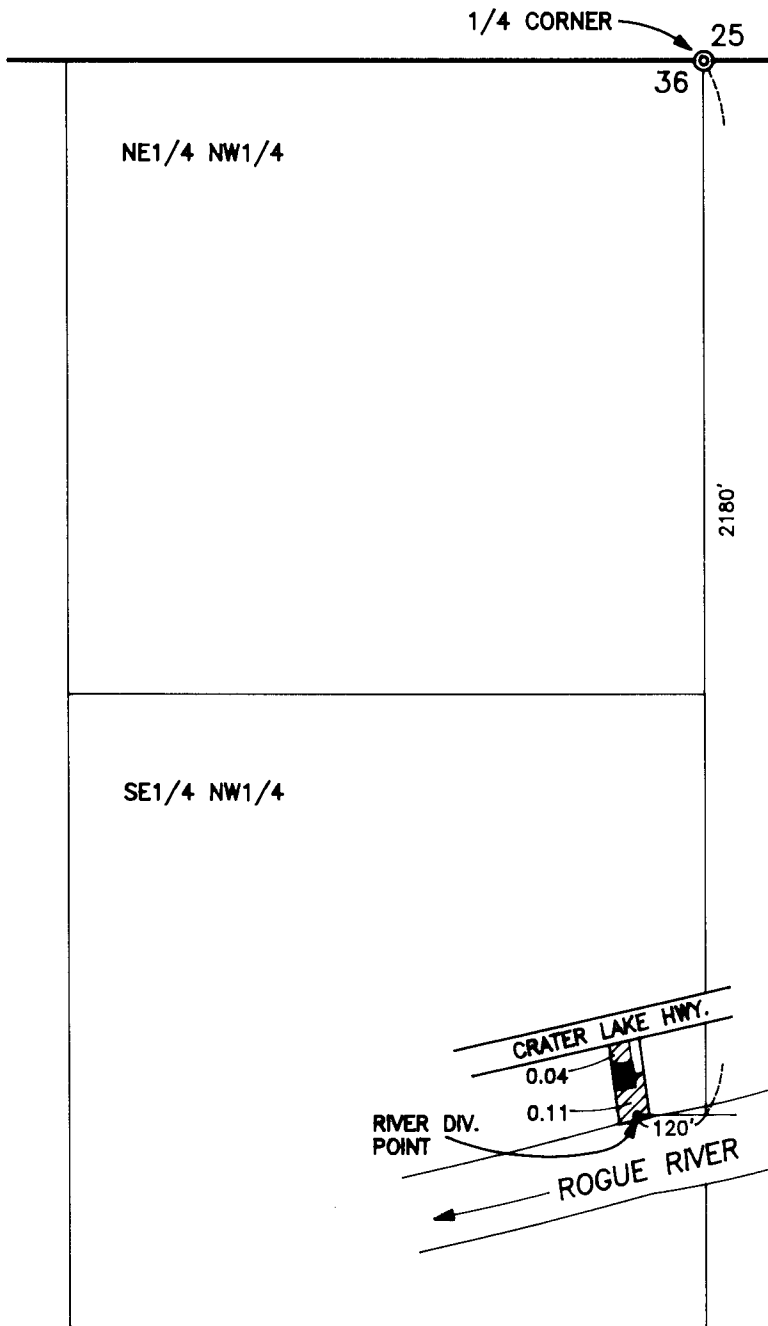

SCALE 1" = 400'



NOTE: MAP PREPARED FOR WATER RIGHT PURPOSES ONLY, NOT FOR PROPERTY BOUNDARY LOCATIONS.

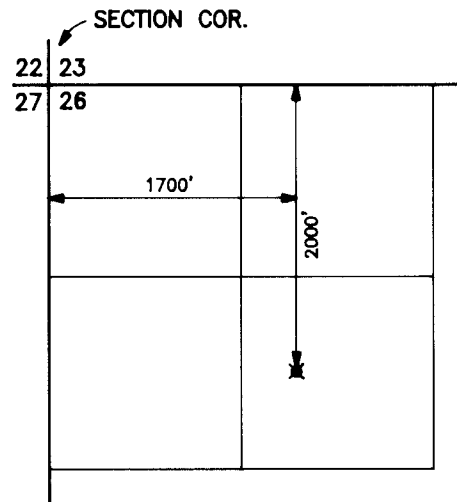


LOST CREEK RESERVIOR
POINT OF DIVERSION
T.33S.,R.1E.,W.M.
SCALE 1" = 1320'

FINAL PROOF MAP

APPLICATION No. S-76964
PERMIT No. 52291

IN THE NAME OF
GARY ENDICOTT

MAP PREPARED SEPTEMBER 13, 2000 BY GARY D. KAISER

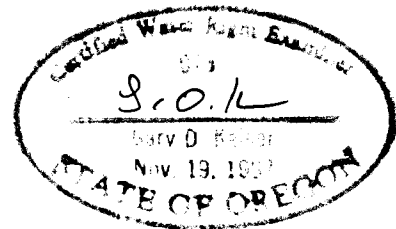

RECEIVED

OCT 16 2000

WATER RESOURCES DEPT
STATE OF OREGON