

RECEIVED T. 34 S., R. 8 W., W.M.

AUG 27 1999

SECTION 24, SE 1/4

R. 8 W.
R. 7 W.

WATER RESOURCES DEPT.
SALEM, OREGON



1" = 400'

6

EL RIO ORO
M.S. 404

MAGNOLIA M.S. 404

5

RIVER

4

ROGUE


0.95 AC.

0.55 AC.

DIVERSION IS 1410 FT.
NORTH AND 77 FT.
WEST OF THE SE
CORNER OF SECTION
24.

7

8

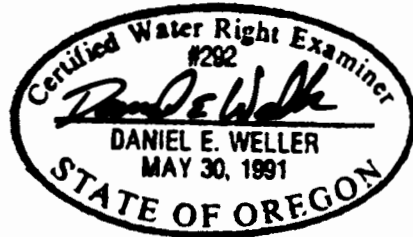

APPLICATION NO. S-73692

PERMIT NO. 52752

B.C.

FINAL PROOF MAP

IN NAME OF

UNITED STATES BUREAU OF LAND MANAGEMENT

WRE 6047A

SURVEYED: JULY 15, 1998

THE PURPOSE OF THIS MAP IS FOR IDENTIFYING THE LOCATION OF THE WATER RIGHT ONLY AND IS NOT INTENDED TO PROVIDE LEGAL DIMENSIONS OR LOCATION OF PROPERTY OWNERSHIP LINES.

U.S. BUREAU OF LAND MANAGEMENT-OSO
BRANCH OF GEOGRAPHIC SCIENCES

DWG: RANDROGE

EXECUTED BY:
DANIEL E. WELLER, PLS, CWRE
P.O. BOX 2965
PORTLAND, OREGON 97208