

**TOWNSHIP 37 SOUTH, RANGE 6 WEST, W.M.
SECTION 15**

Josephine County, Oregon

**Ronald M. and Beverly B. Abram
1613 Fish Hatchery Road
Grants Pass, OR. 97527**

**Final Proof Survey
Application S-84437, Permit 53753**


RECEIVED

JUN 14 2002

**WATER RESOURCES DEPT.
SALEM, OREGON**



**Scale 1" = 400'
May 14, 2002**

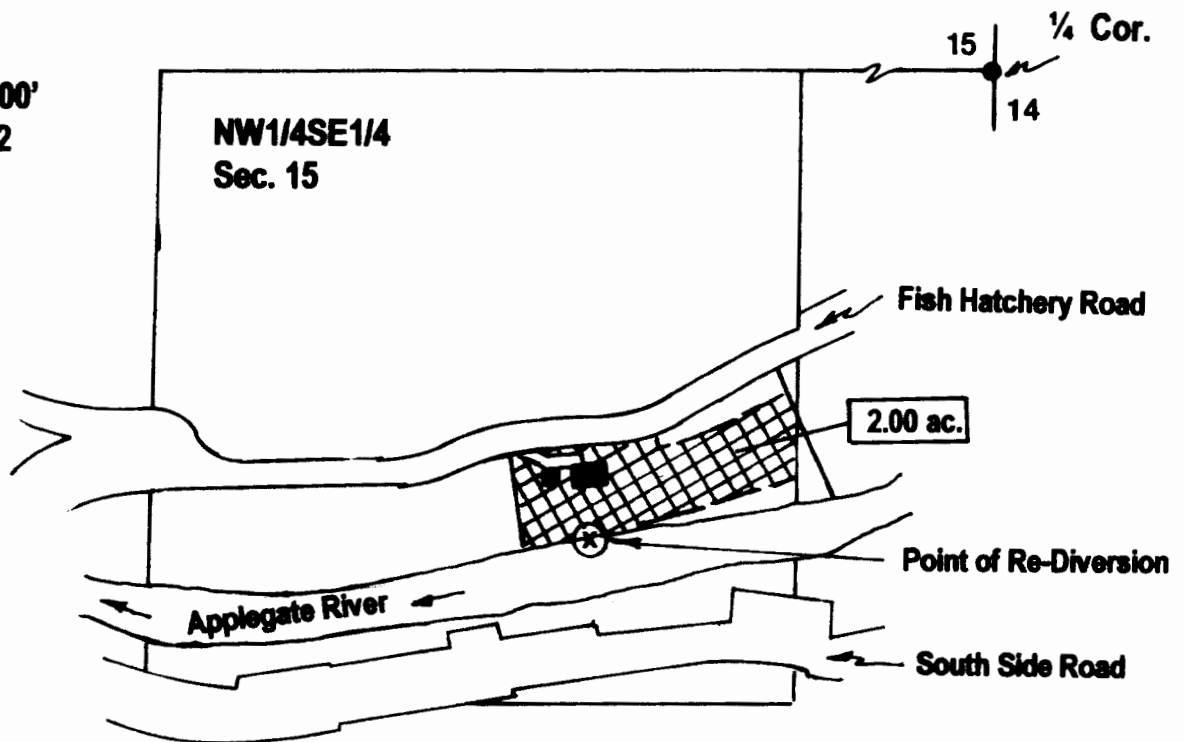

**Point of Diversion location, Applegate
Reservoir; NW 1/4 Sec. 36, T. 40 S., R. 4 W., W.M.**

**Point of Re-Diversion from Applegate River
NW1/4SE1/4 Sec. 15, T. 37 S., R. 6 W., W.M.
1000 feet South and 1830 feet West from the
East 1/4 corner Section 15.**



**This map was prepared for the purpose of
identifying the location of a water right and
is not intended to provide legal dimensions
or locations of ownership lines.**

**Certified Water Right Examiner
HAROLD L. CENTER, P.L.S., C.W.R.E.
2604 David Lane, Medford, OR. 97504
541-535-6108, Fax 541-535-8752
Certified Water Right Examiner No. 152**