


T. 3 S. R. 38 E. W. M.

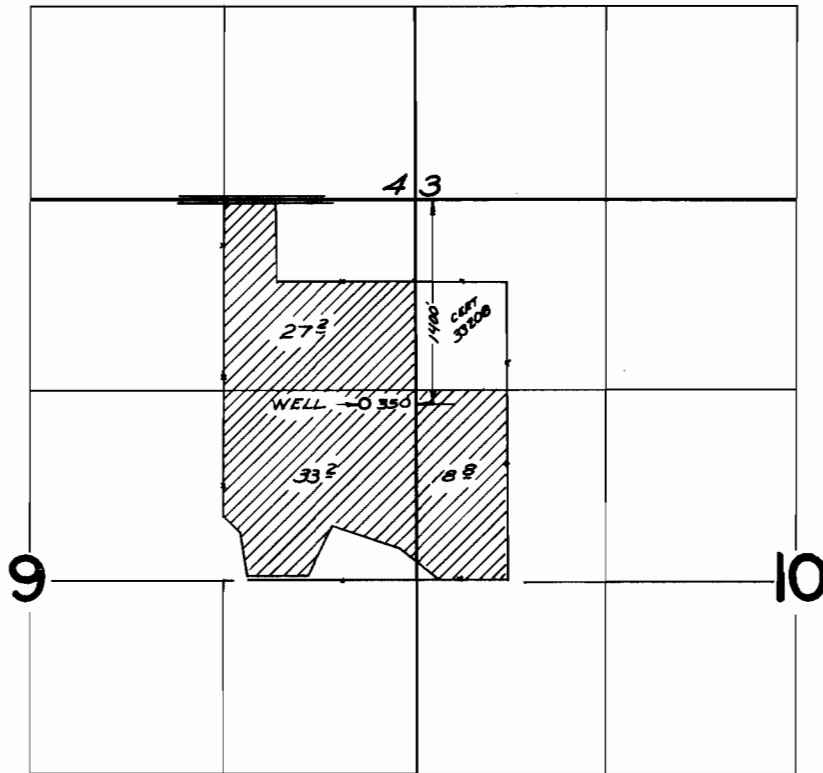

FINAL PROOF SURVEY UNDER

Application No. *G:3412* Permit No. *G:3200*
IN NAME OF
UNION STAKE CHURCH OF JESUS CHRIST
OF LATTER DAY SAINTS

Surveyed *Nov. 4* 1965, by *C. Gardner*
INSPECTED Aug 31, 1967 by *V. Garner*