


T. 33 S., R. 1 E., SEC. 26, W.M.

DIVERSION IS LOCATED  
300 FT. SOUTH AND  
2000 FT. EAST OF THE  
NW CORNER OF SECTION  
26.

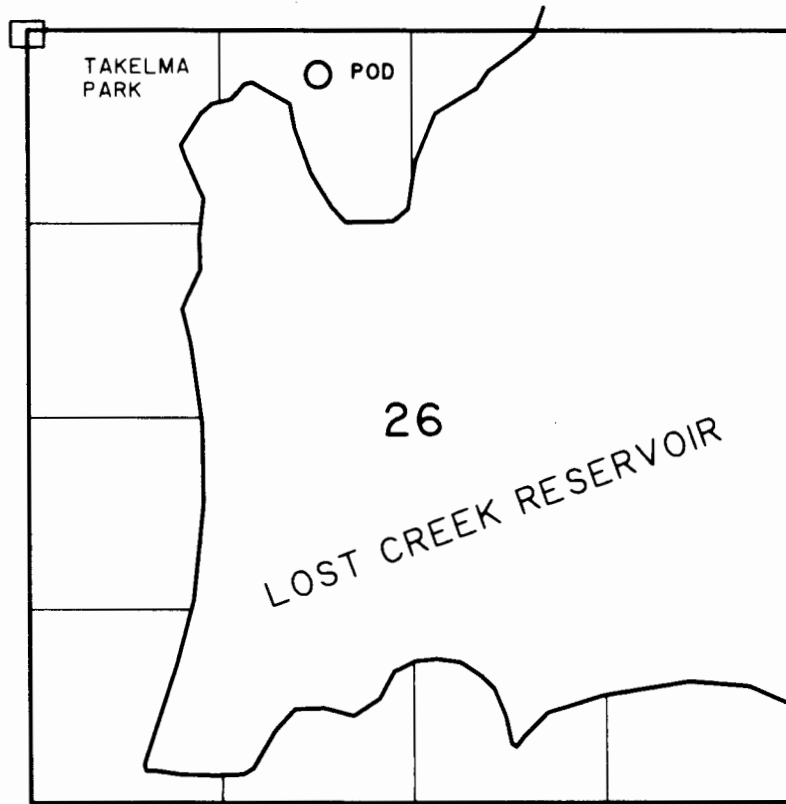

1" = 1320'

RECEIVED

FEB 29 2000

REGISTERED


### FINAL PROOF MAP

IN NAME OF

## UNITED STATES BUREAU OF LAND MANAGEMENT

APPLICATION NO. S-69132

PERMIT NO. 53321

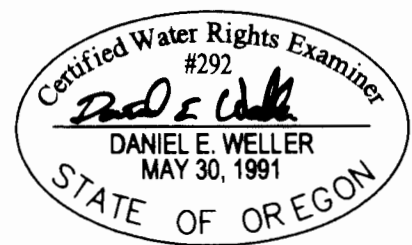

EXPIRES 6/30/04

SURVEYED: FEBRUARY 29, 2000

THE PURPOSE OF THIS MAP IS FOR IDENTIFYING THE LOCATION OF THE WATER RIGHT ONLY AND IS NOT INTENDED TO PROVIDE LEGAL DIMENSIONS OR LOCATION OF PROPERTY OWNERSHIP LINES.

U.S. BUREAU OF LAND MANAGEMENT-OSO  
BRANCH OF CADASTRAL SURVEY

DWG: LOST

EXECUTED BY:  
DANIEL E. WELLER, PLS, CWRE  
P.O. BOX 2965  
PORTLAND, OREGON 97208