


T27S.R6W.W.M.

SECTION 22

NW1/4 NE1/4

SCALE: 1 INCH = 400 FEET

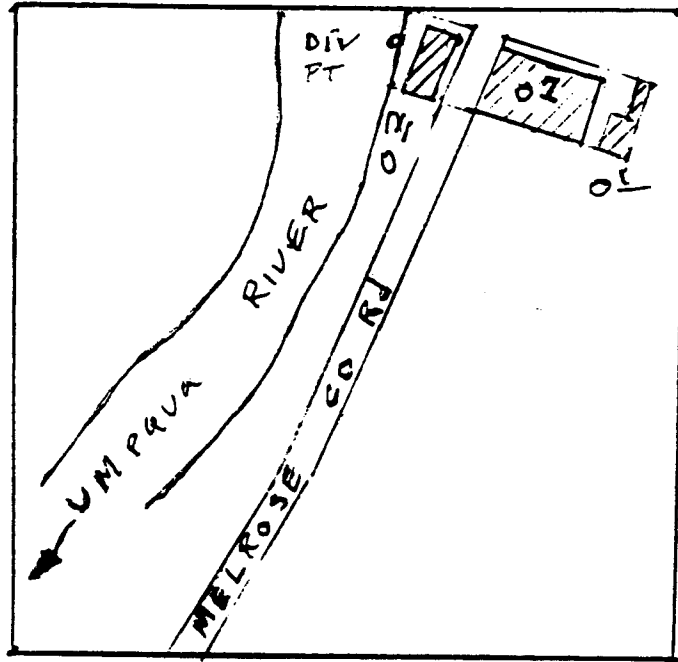

THE PURPOSE OF THIS MAP IS TO IDENTIFY THE LOCATION OF THE WATER RIGHT. IT IS NOT INTENDED TO PROVIDE INFORMATION RELATIVE TO THE LOCATION OF PROPERTY OWNERSHIP BOUNDARY LINES.



FINAL PROOF SURVEY UNDER

Application No. 83540 Permit No. 53403

IN NAME OF
HAROLD R. MEEHL

Surveyed JUN 15 1998 by DUANE KIRBY

RECEIVED

OCT 24 2002

WATER RESOURCES DEPT.
SALEM, OREGON