



Claim of Beneficial Use Map for Washington Family Ranch (Younglife Camp)

- ⊗ Primary 15¹/₂ acres
- ⊙ Supplemental 37²/₂ acres

T. 8 S., R. 18 E., W. M.
Section 35
SE 1/4 SE 1/4

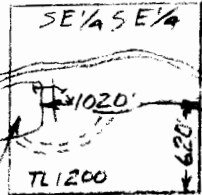

Scale 1" = 1320'
(4" = 1 mile)

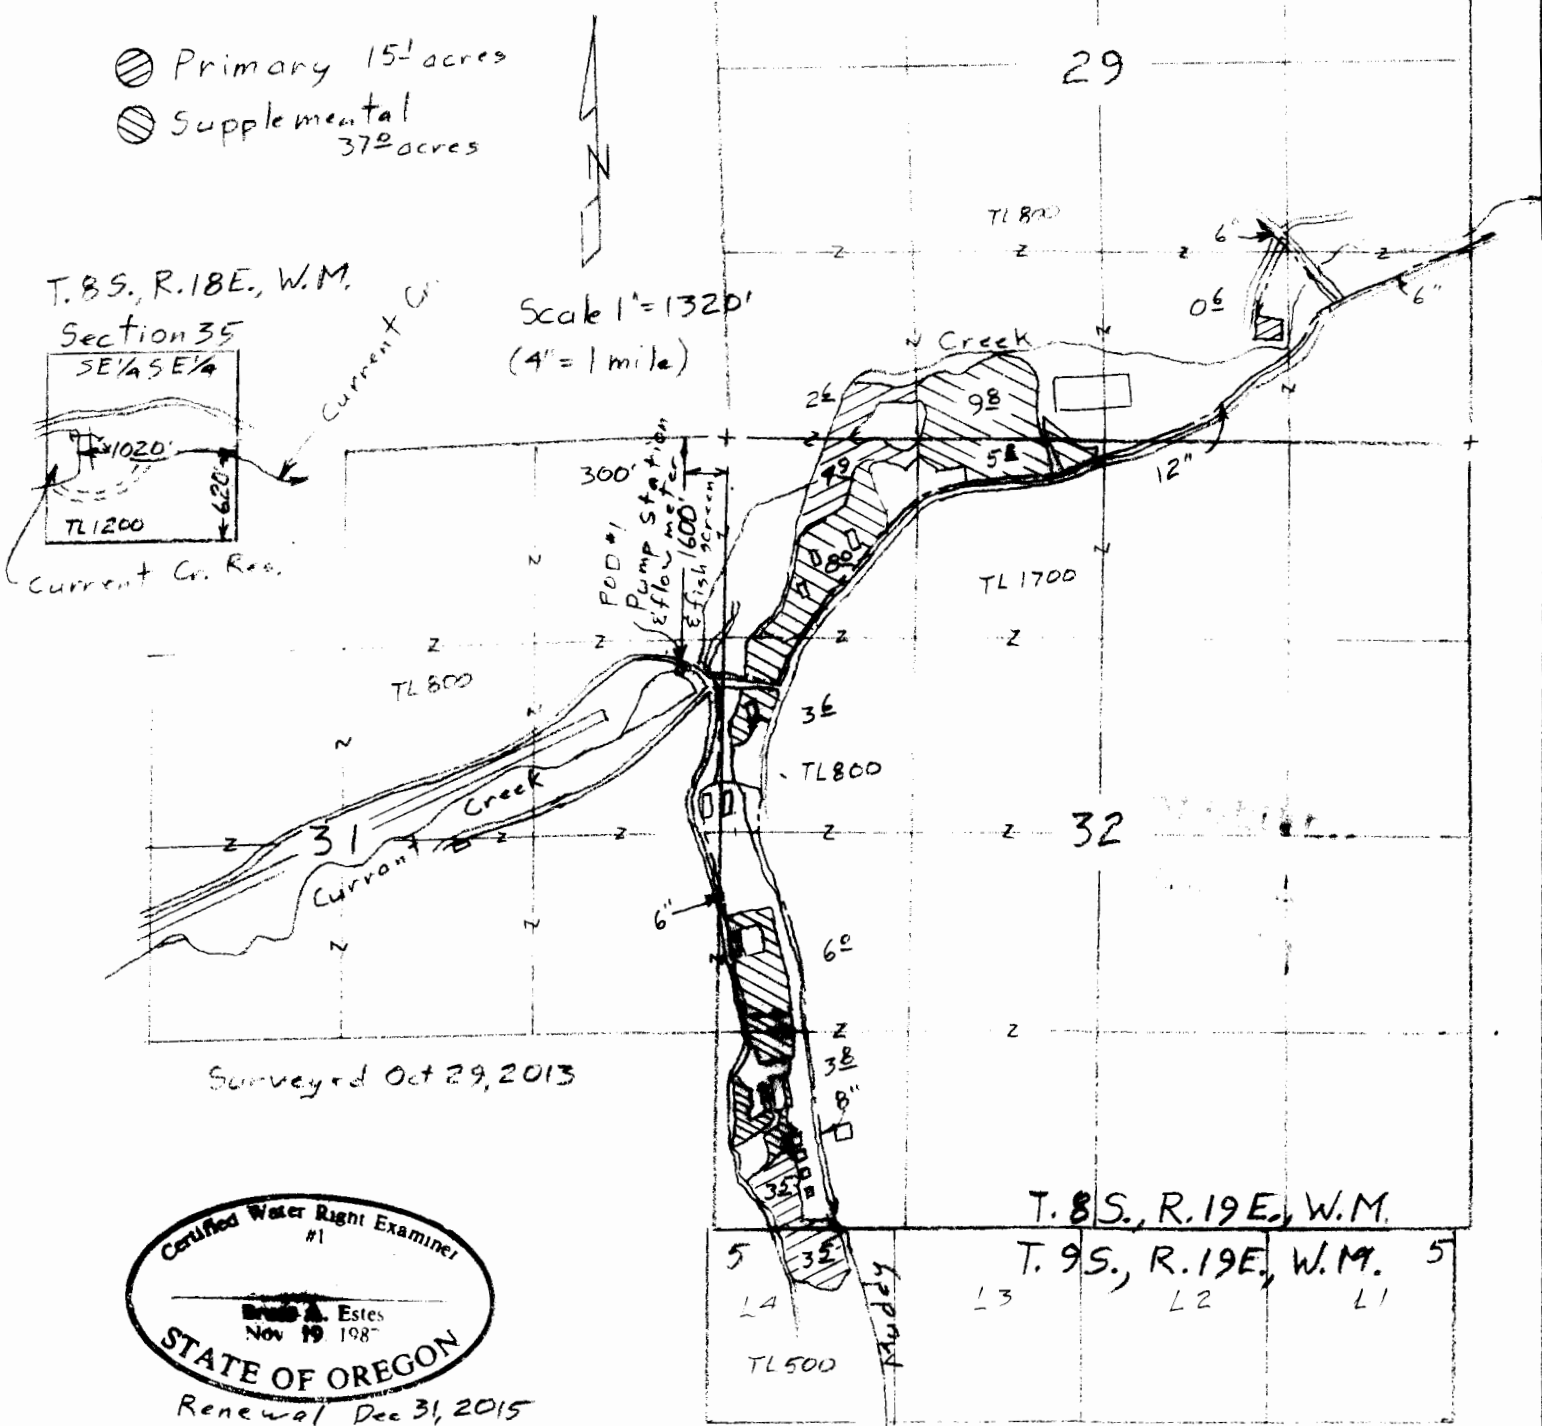

Surveyed Oct 29, 2013




ESTES SURVEYS
 PO Box 7518 60382 Arnold Mt
 Salem, OR 97305-7518 Bend, OR 97702
 (503) 685-7555 (541) 382-2307

This map is for the purpose of locating a water right only and has no intent to provide legal dimensions or the location of property lines.

T. 8 S., R. 19 E., W. M.
T. 9 S., R. 19 E., W. M.

APP 5-72591
Per 52584
T-8558

T. 8 S., R. 19 E., W.M.

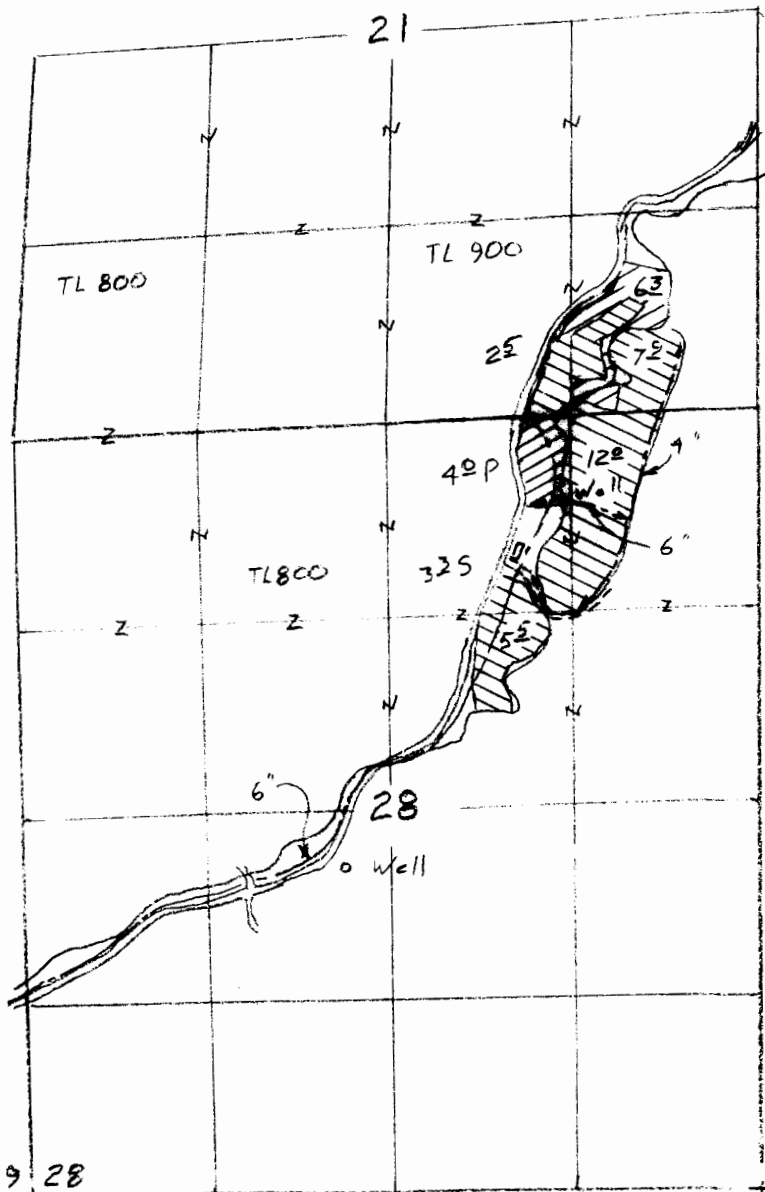

Scale 1" = 1320'
(4" = 1 mile)

- ⊗ Primary 10³ acres
- ⊗ Supp 31² acres


RECEIVED
APR 21 2014
OWRD

29 28
31 32

Surveyed Oct. 29, 2013

Claim of Beneficial Use Map
for
Washington Family Ranch
(Younglife Comp)

App S-72591
Per 52584
T-8558

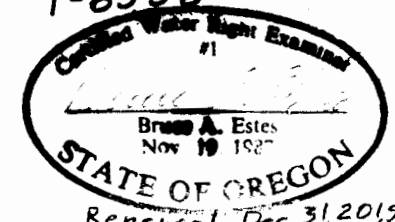

Renewal Dec 31 2015
Sheet 2 of 2

This map is for the purpose of
locating a water right only
and has no intent to provide
legal dimensions or the location
of property lines.

ESTES SURVEYS
 PO Box 17519 60382 Arnold Rd
 Salem, OR 97305-7519 Bend, OR 97702
 (503) 585-7593 (541) 382-7391