


CLAIM OF BENEFICIAL USE  
SURVEYED AUGUST 9, 2001  
BY DUANE W. KIRBY  
FOR RICHARD M. KEARNEY  
& NATALIE KEARNEY  
APPLICATION NO. 580204  
PERMIT NO. 52705  
T32S,R4W,W.M.  
SECTION 7  
TAX LOT 300

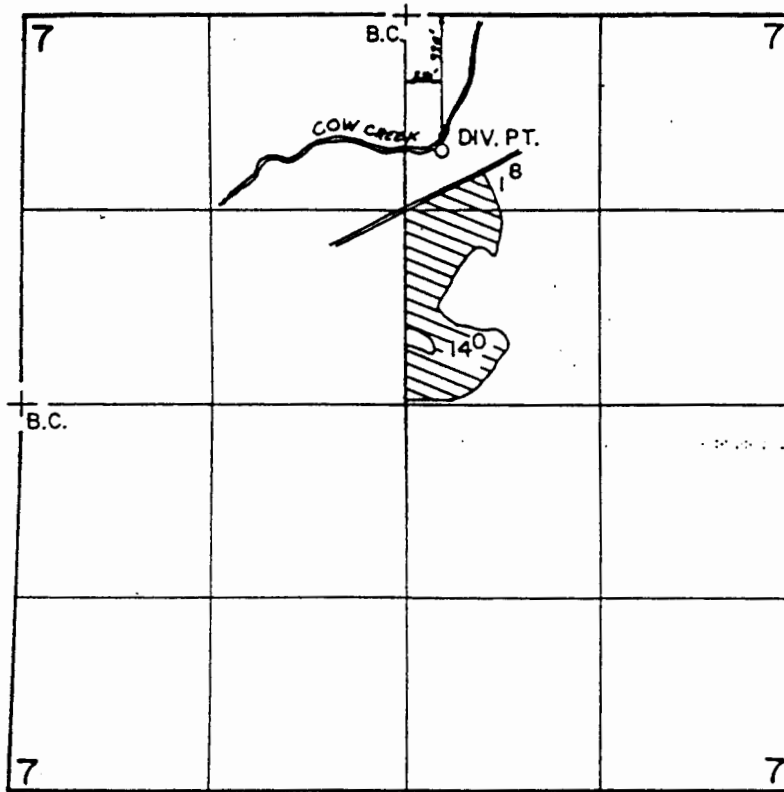

SCALE: 4" = 1 MILE

THE PURPOSE OF THIS MAP IS TO IDENTIFY THE LOCATION OF THE WATER RIGHT. IT IS NOT INTENDED TO PROVIDE INFORMATION RELATIVE TO THE LOCATION OF PROPERTY OWNERSHIP BOUNDARY LINES.

