


Willow Valley Irrigation District
 Township 40 South, Range 14 East, W.M.
 Final Proof for Permit 22962

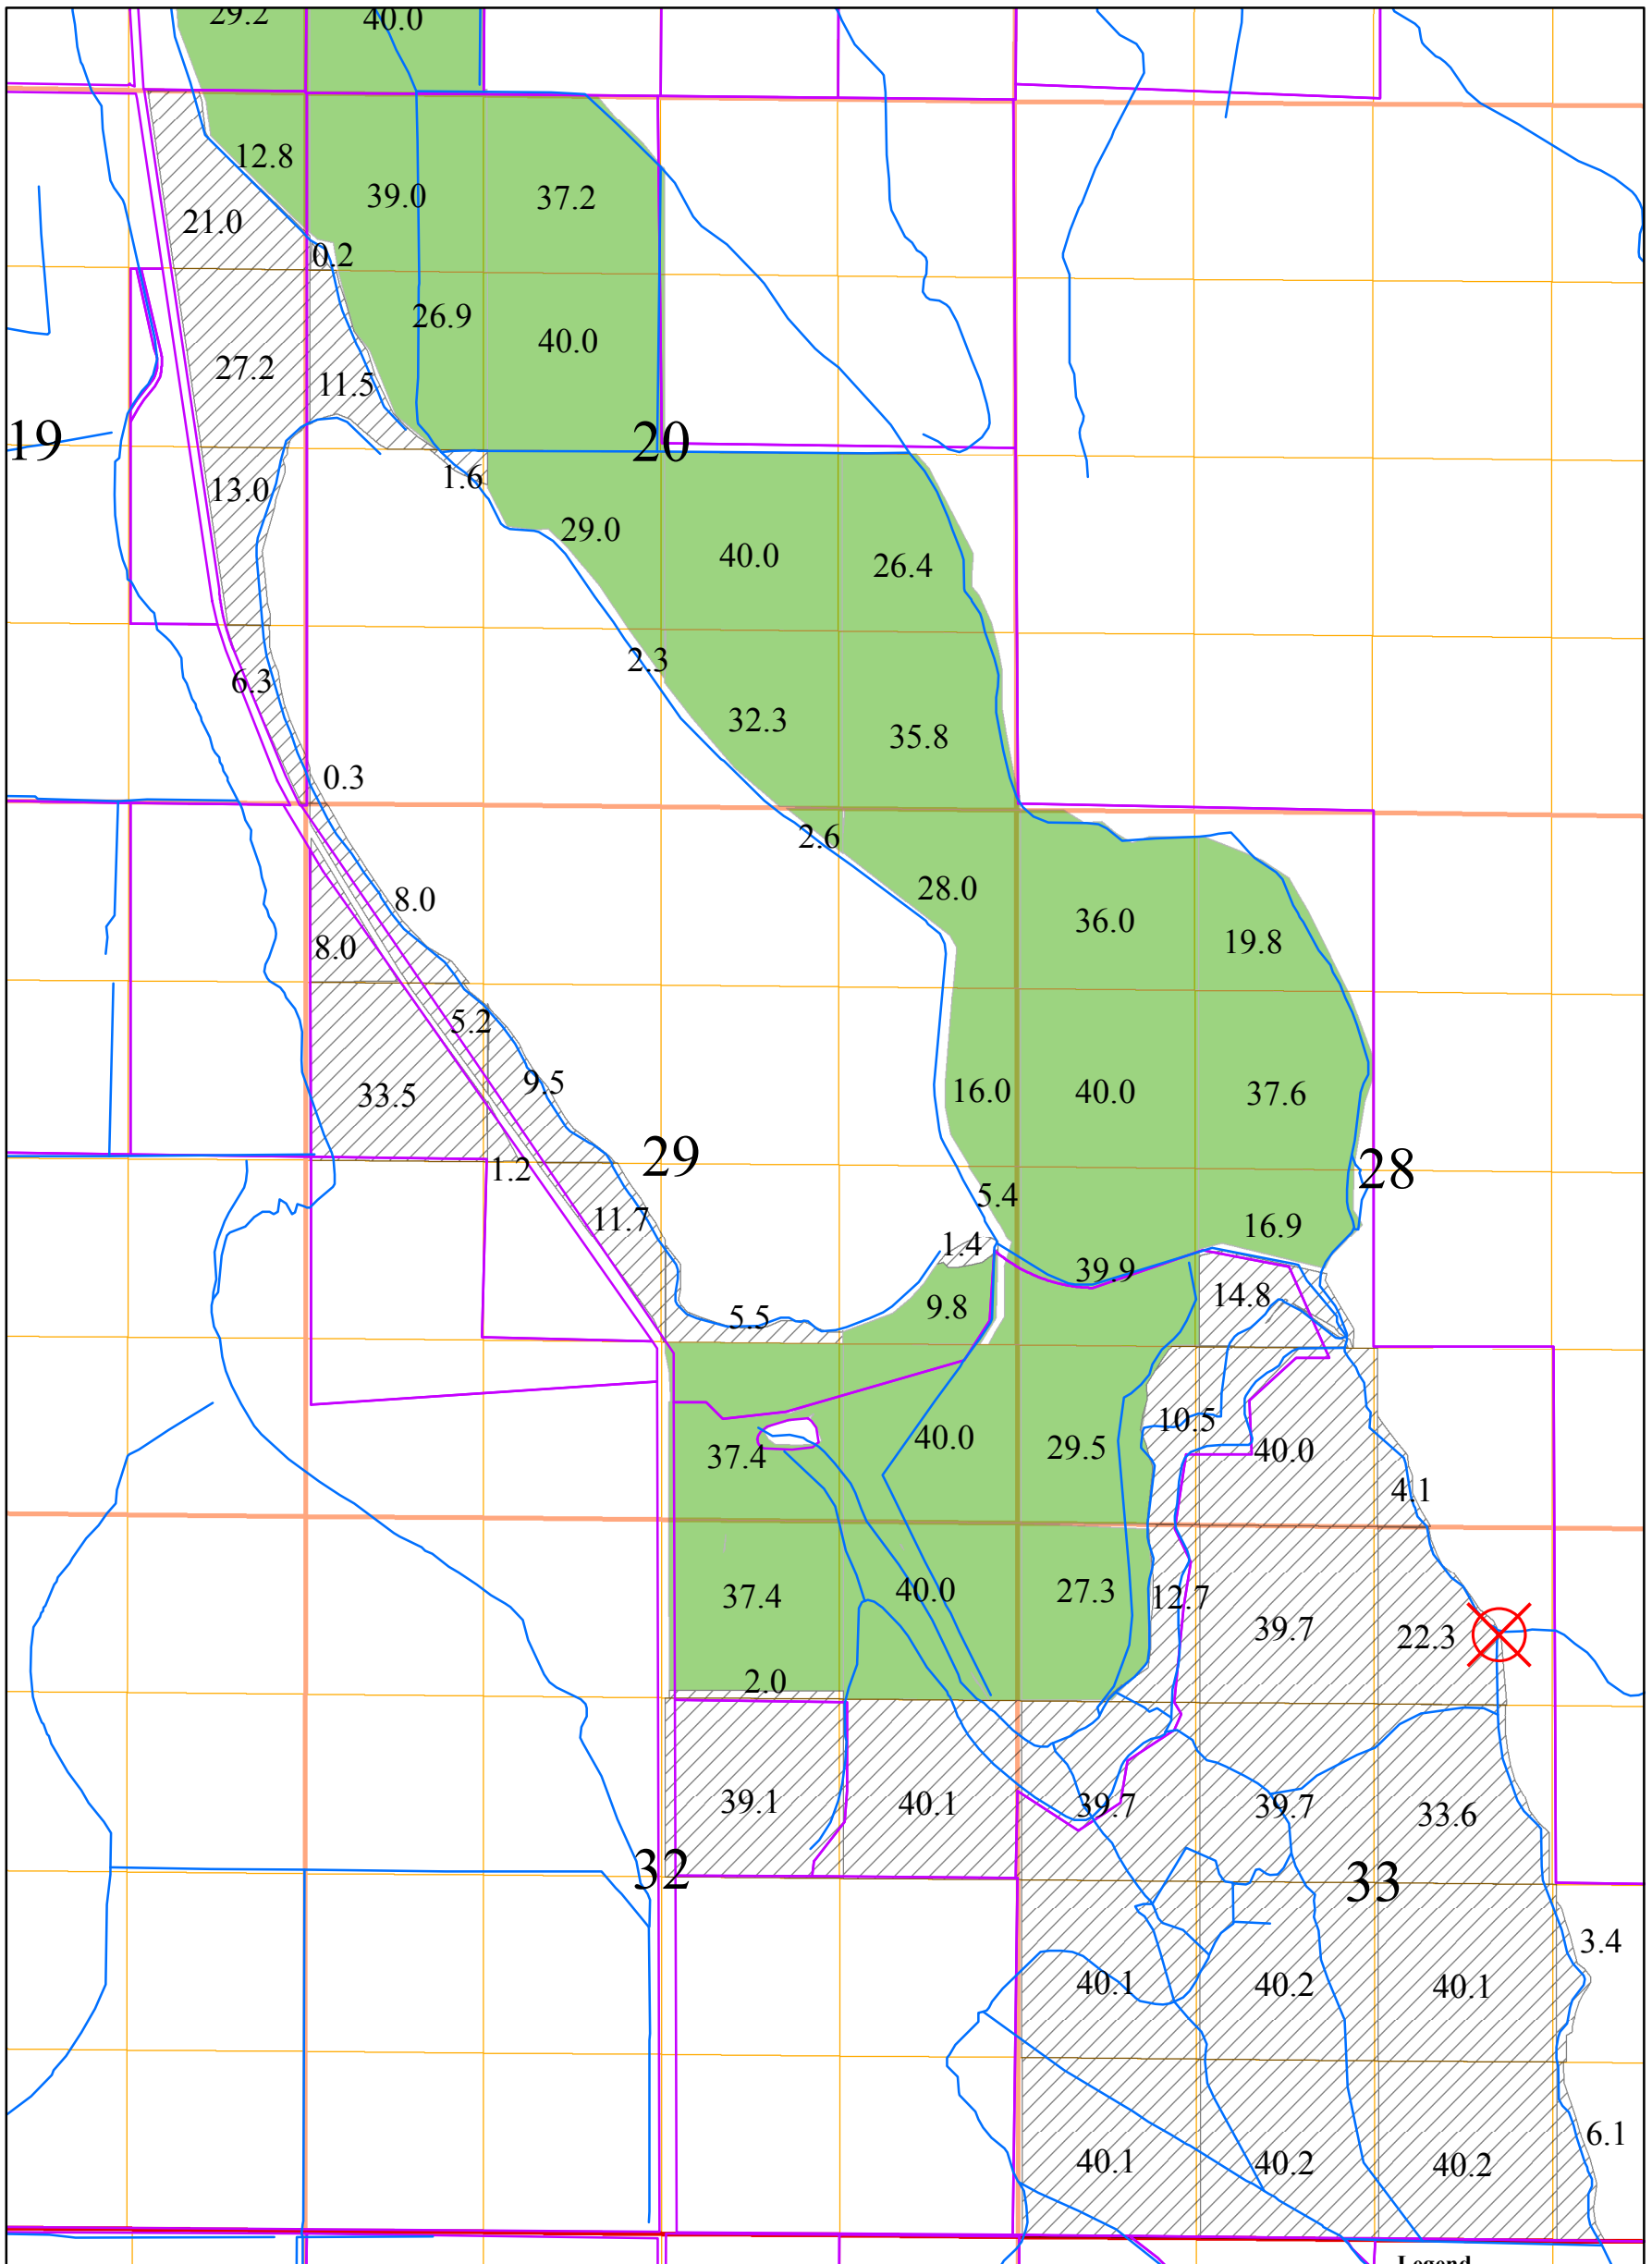

1 inch = 1,320 feet



Woolen Creek: South 49 Degrees 20 Minutes East, 1227 Feet from the N 1/4 Corner Section 33

October 2014

WillowValley
Permit_S
 9416; 18863; 25660
 22962