


Willow Valley Irrigation District

Township 41 South, Range 14 East, W.M.

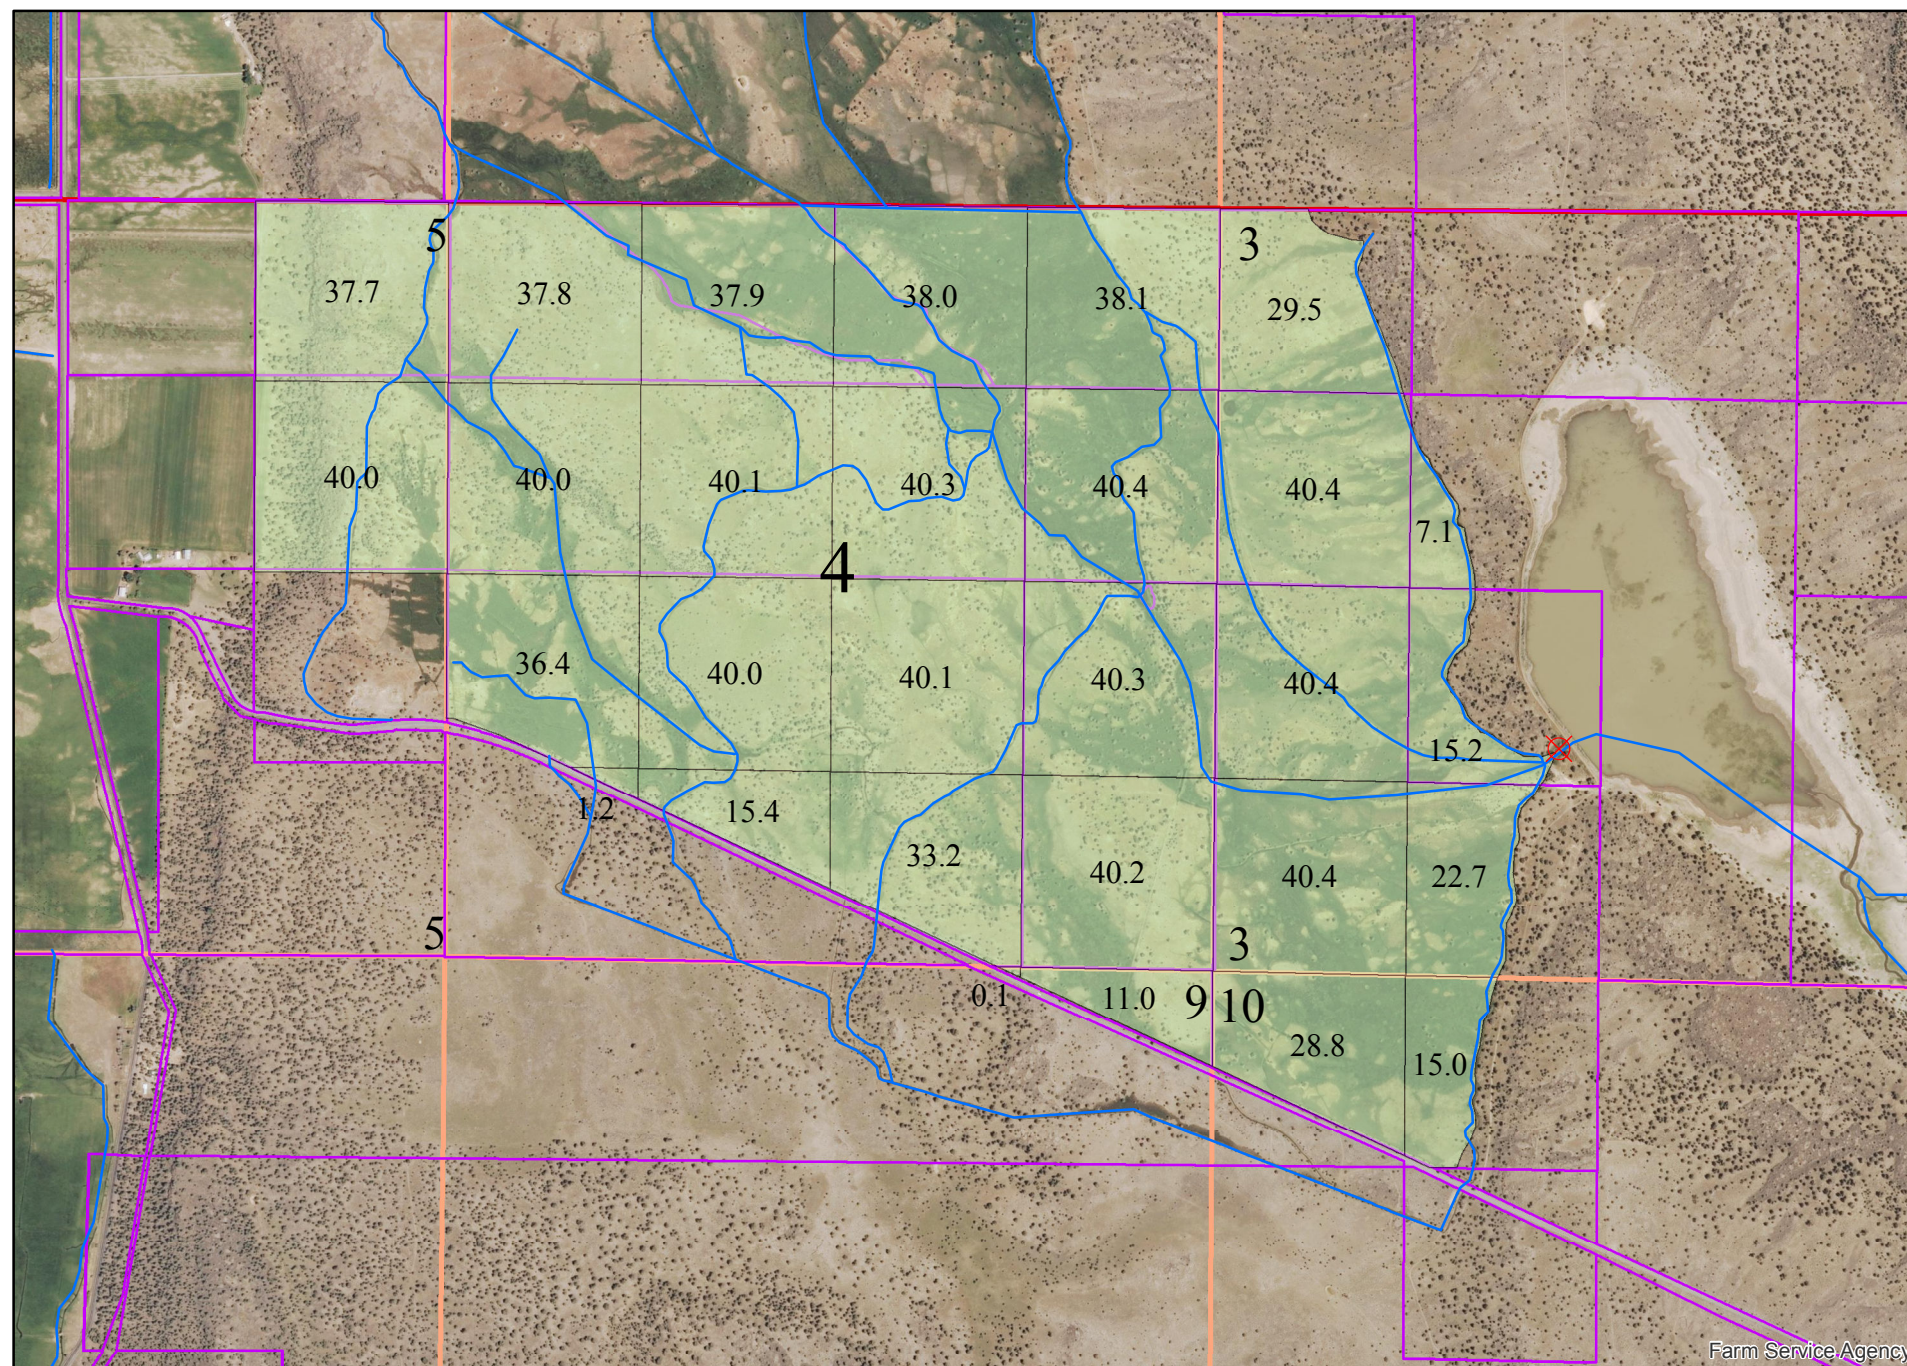

1 inch = 1,320 feet

Proposed Final Proof
 Primary Acres Permit 24041
 Supplemental Acres Permit 51108

3 Mile Flat Reservoir: 1410 Feet North and 2600 Feet East from the SW Corner of Section 3

October 2014

Farm Service Agency