


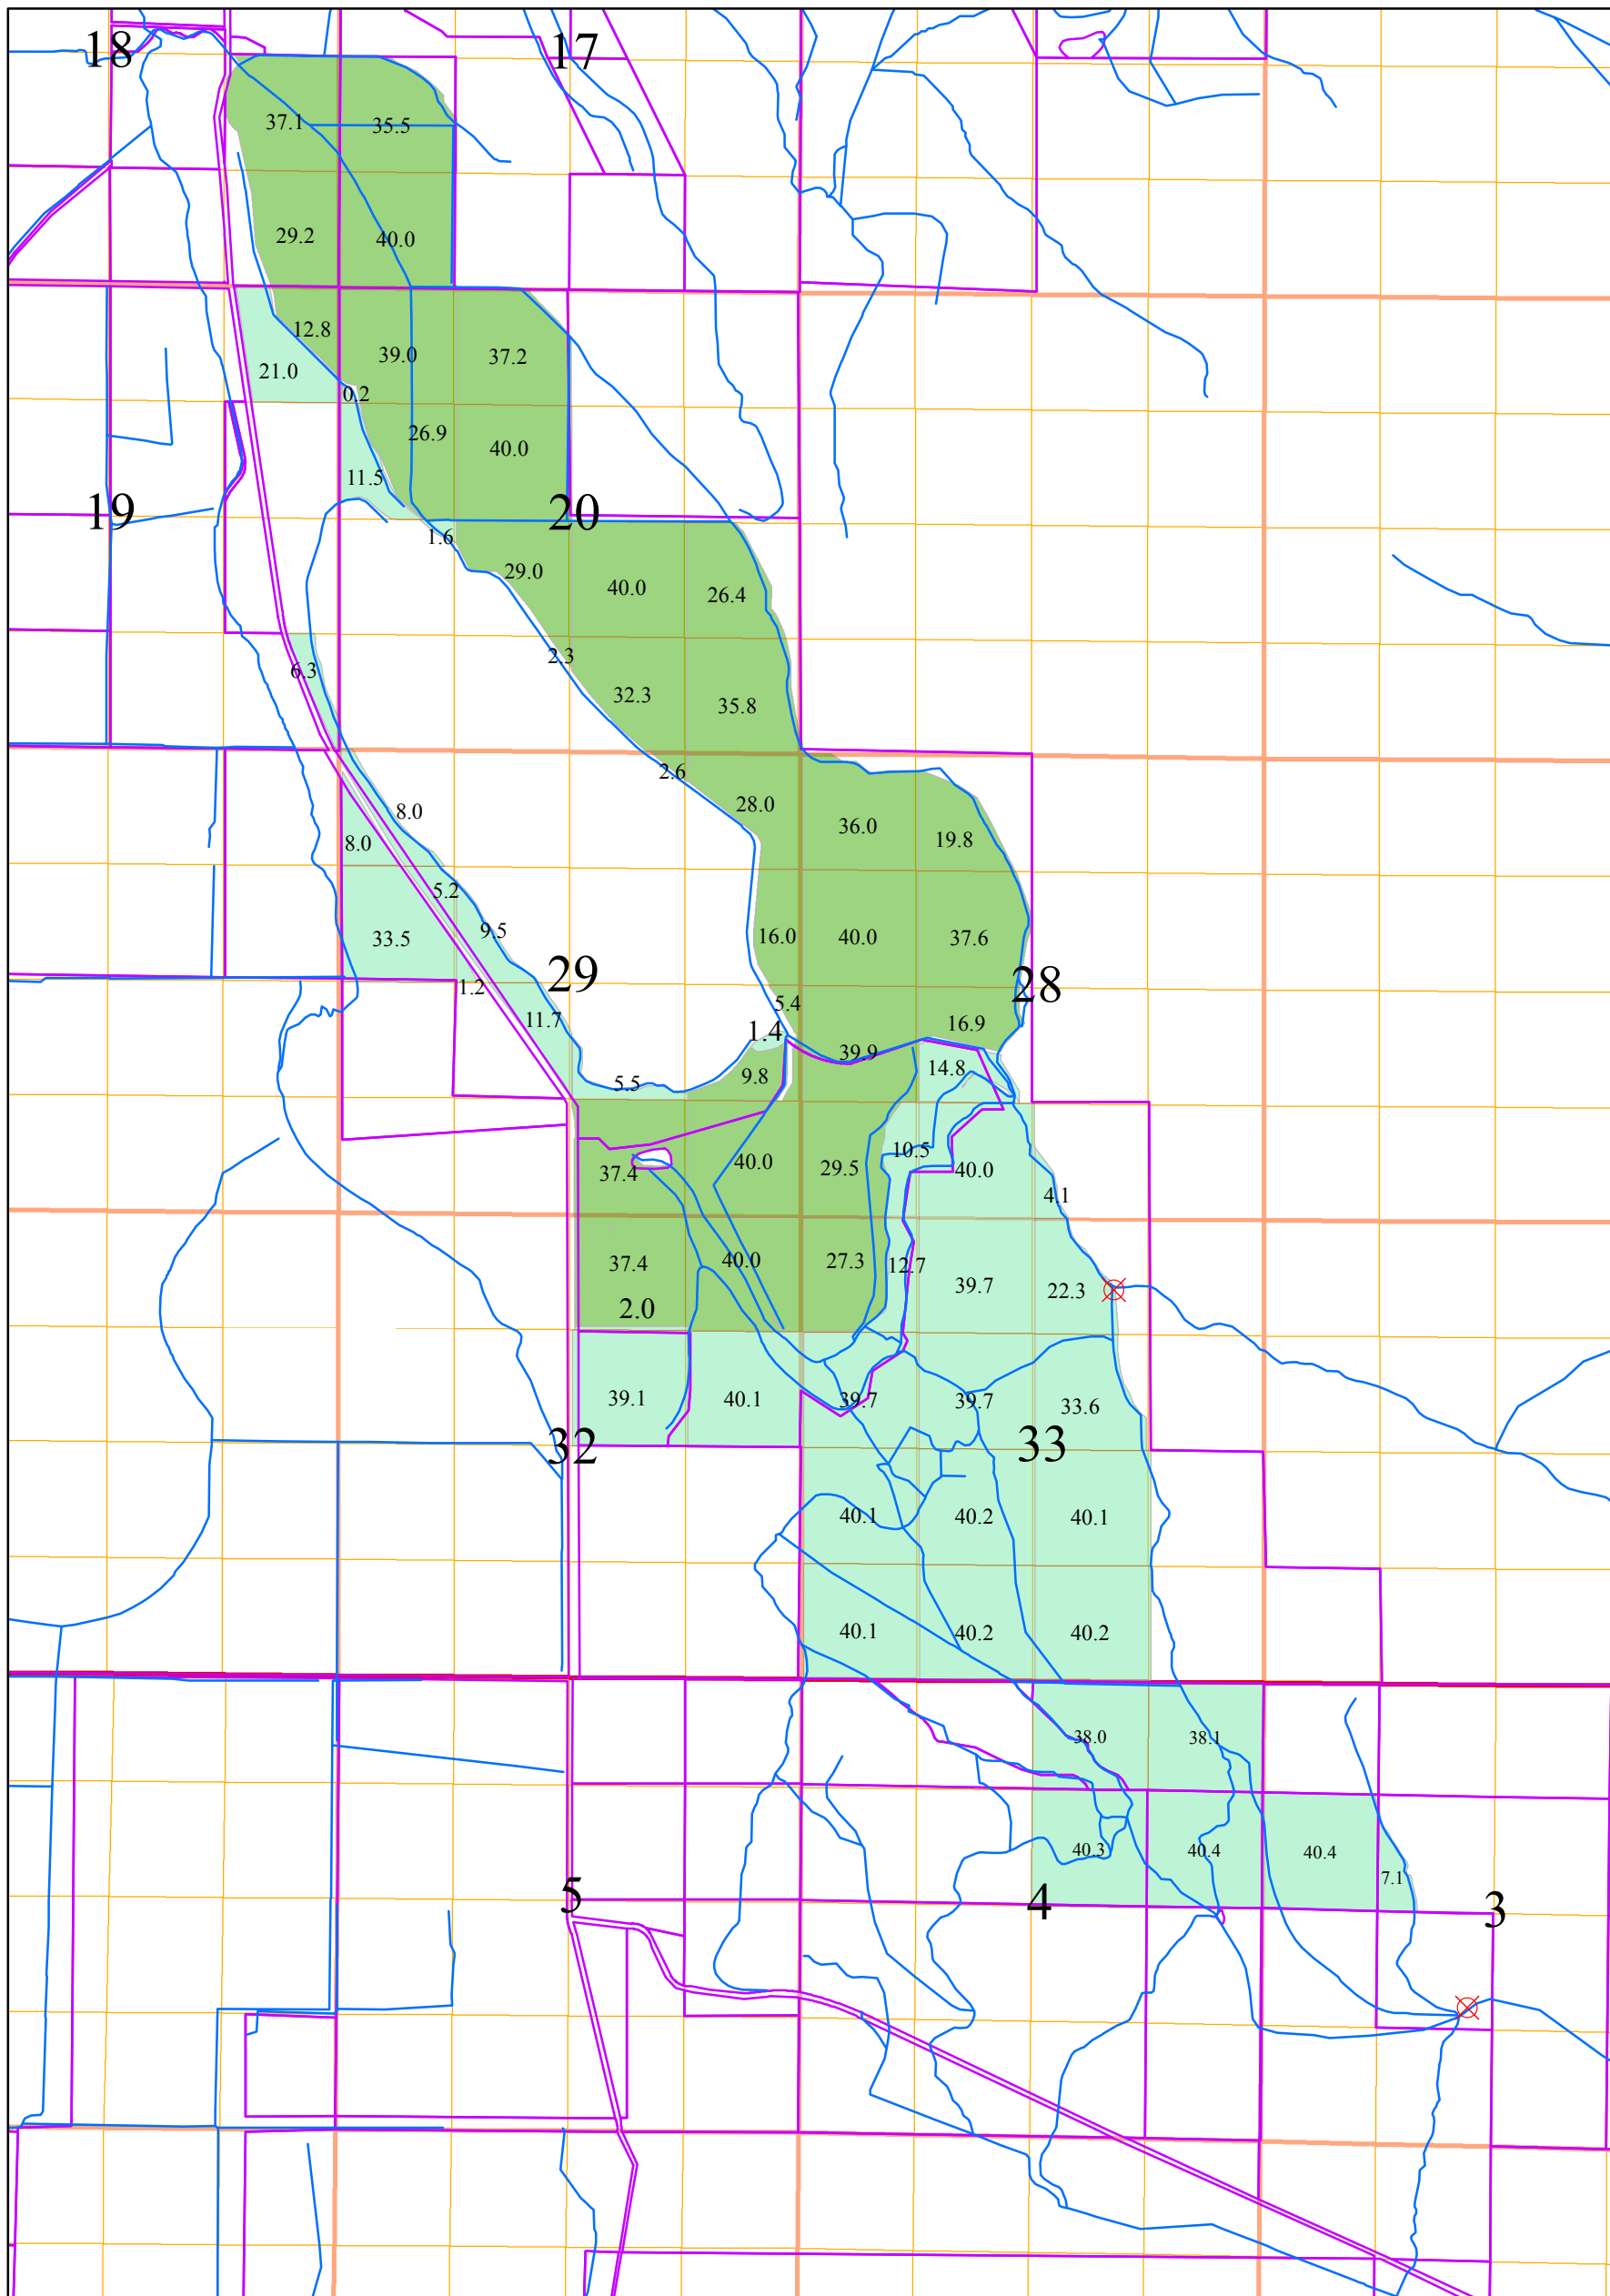

Willow Valley Irrigation District
Townships 40 and 41 South, Range 14 East, W.M.
Proposed Final Proof for Supplemental Permit 27387

1 inch = 2,000 feet



Willow Valley Reservoir: 50 Feet South and 550 Feet East from NW Corner, Section 19,
Lot 1 (NW1/4 NW 1/4) Section 19, Township 41 South, Range 14.5 East, W.M.

October 2014