


Willow Valley Irrigation District
 Townships 40 and 41 South, Range 14 East, W.M.
 Final Proof for Supplemental Permit 51108

1 inch = 2,000 feet

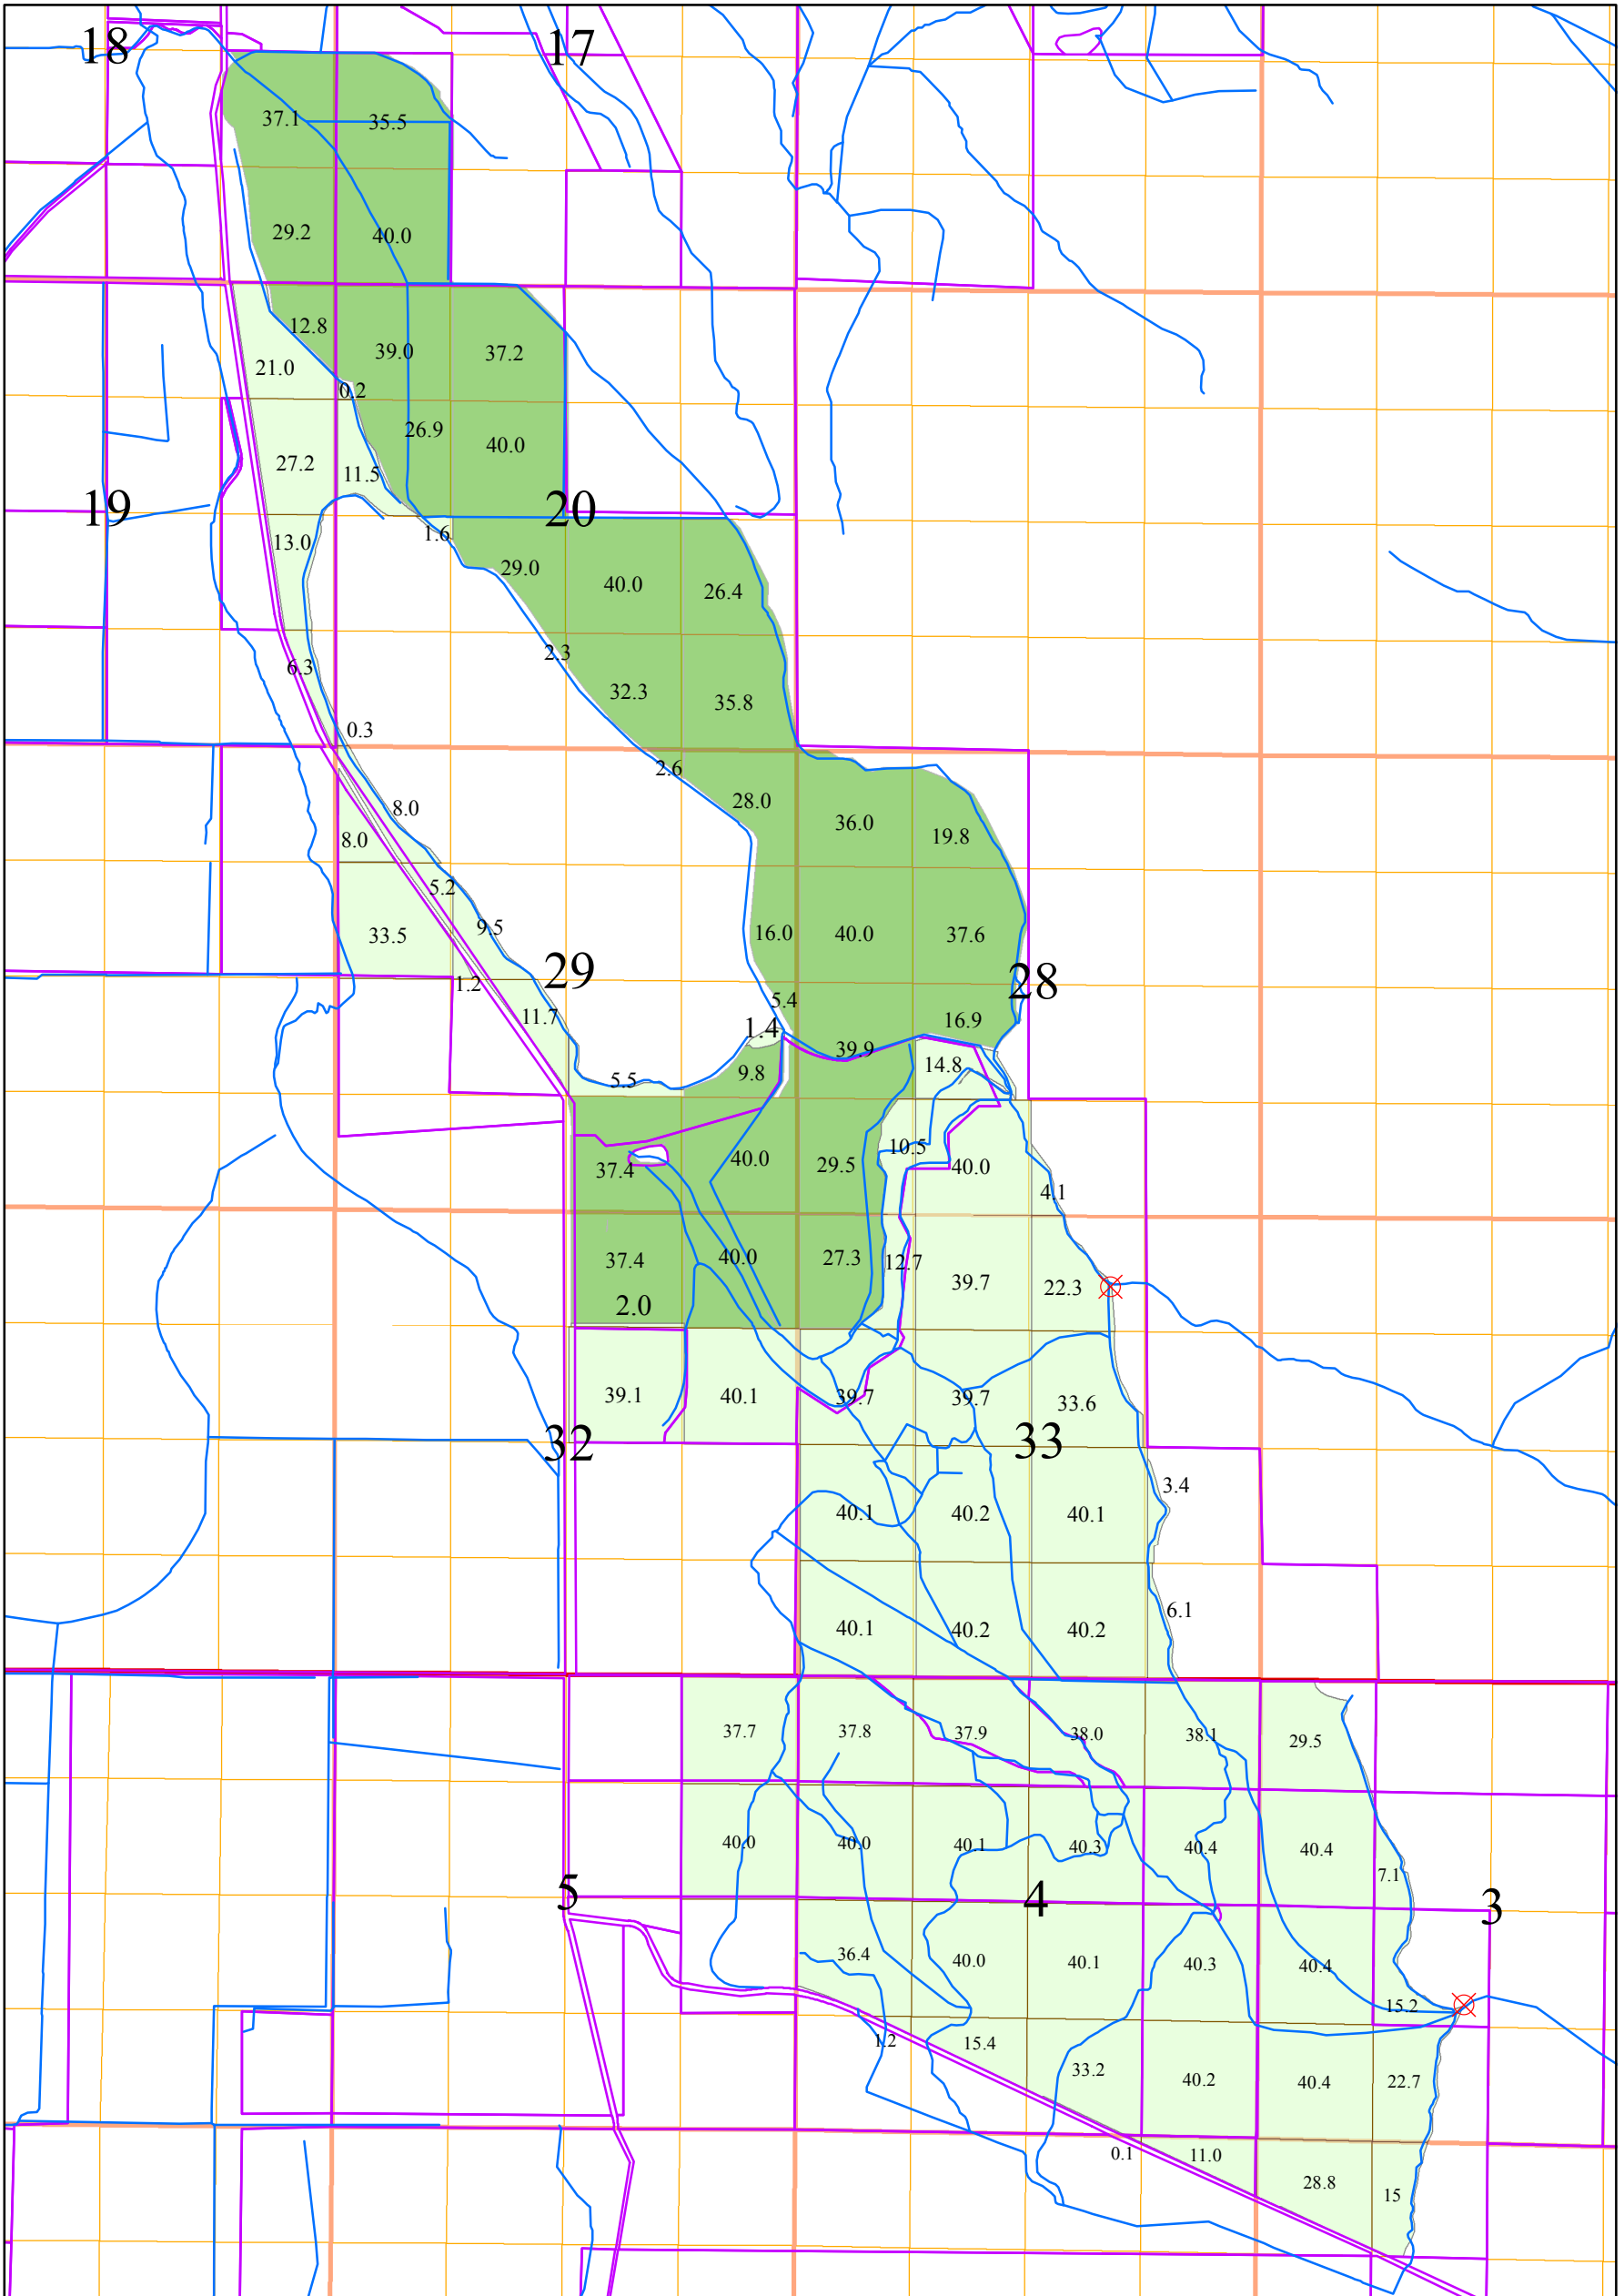

3 Mile Flat Res: 1410 Feet North and 2600 Feet East from SW Corner Section 3,
 NE1/4 SW1/4, Section 3, Township 40 South, Range 14 East, W.M.

October 2014