


# Claim of Beneficial Use Place of Use Map (Acreage Shown by Tax Lot within each QQ within each DLC)

Permit S- 54030 (Application S-84780)

Township 10 South, Range 3 West (W.M.)

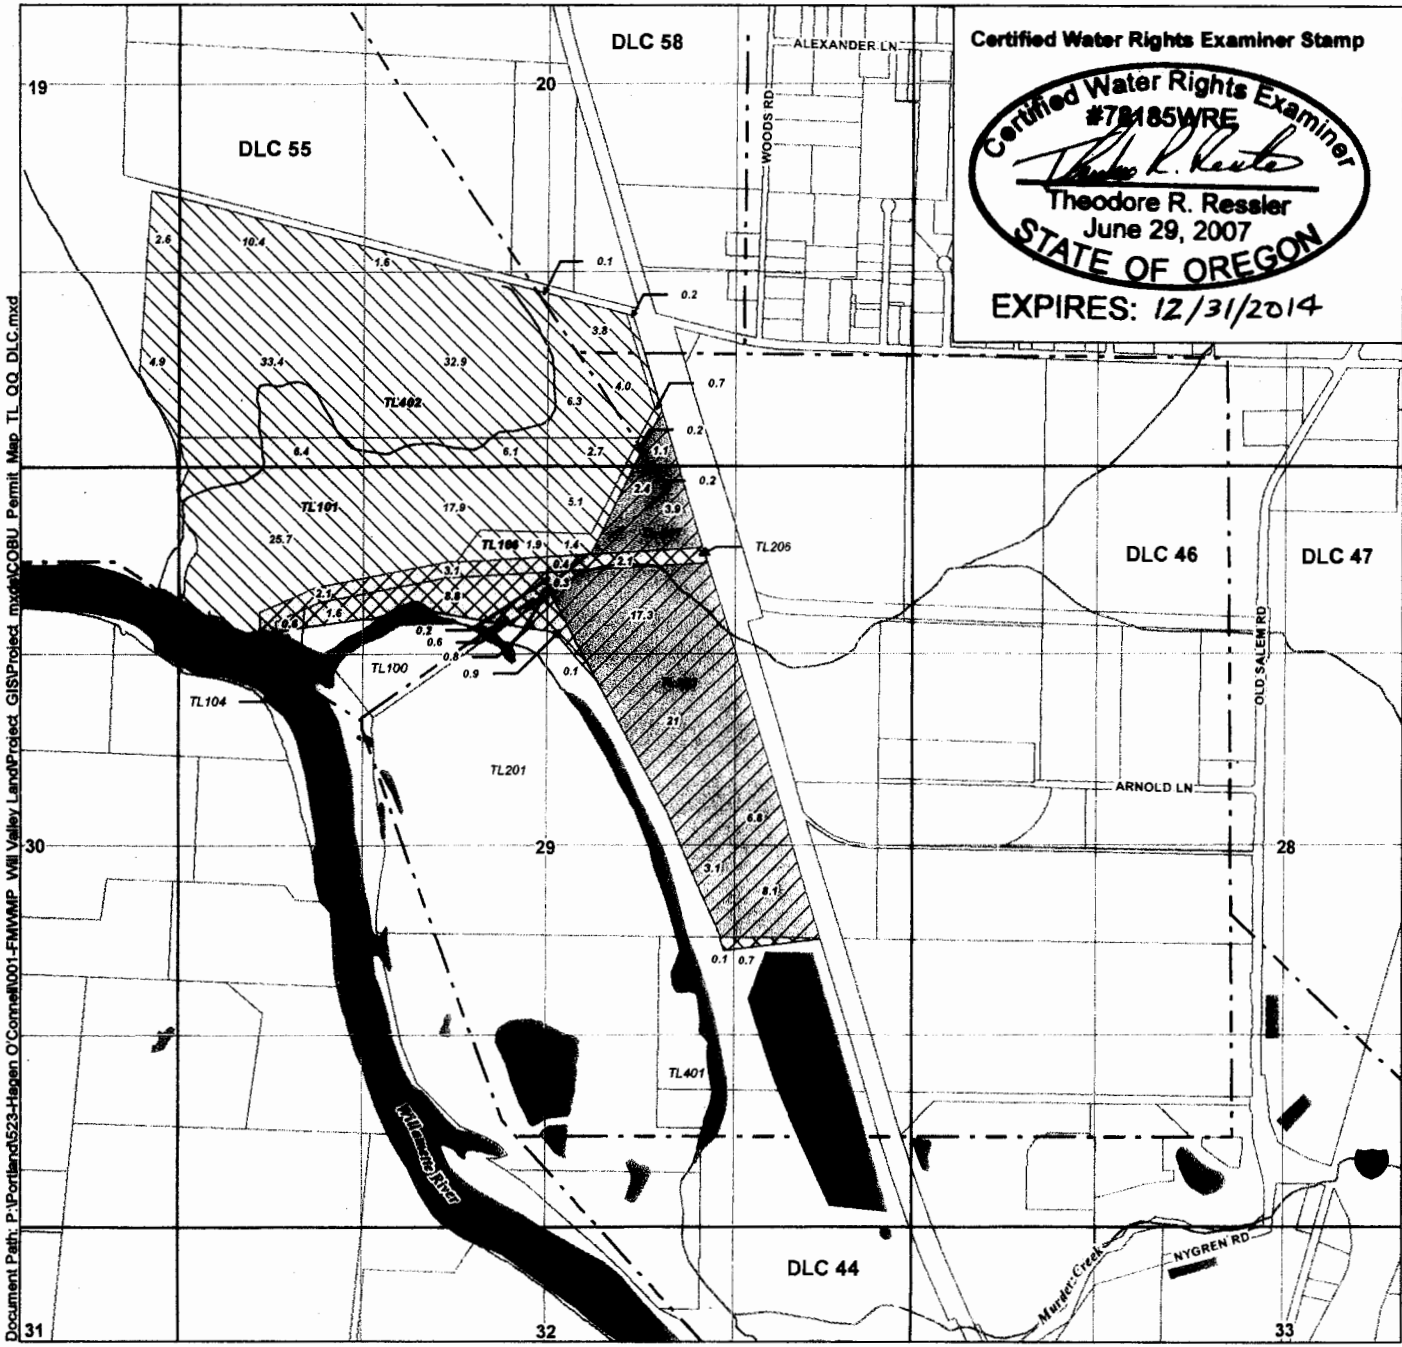

**Certified Water Rights Examiner Stamp**

Document Path: P:\Portland\623-Hagan, O'Connell\001-FMWMP - Will Valley Land\Protect GIS\Protect.mxd\COBU\_Permit\_Map\_TL\_QQ\_DLC.mxd

**LEGEND**

- Portion of Permit in the Name of Willamette Valley Land, LLC.
- Portion of Permit in the Name of FMWMP, LLC.
- Portion of Permit in the Name of International Paper
- Tax Lot
- Donation Land Claim (DLC)
- Watercourse
- Waterbody

**Disclaimer**

This map was prepared for the purpose of identifying the location of a water right only and it is not intended to provide legal dimensions or location of property ownership lines.

**Map Notes**

Date: April 25, 2014  
Data Sources: BLM, City of Albany, USGS  
Prepared By: GSI Water Solutions, Inc.

